


T.14S.R.4W.W.M.

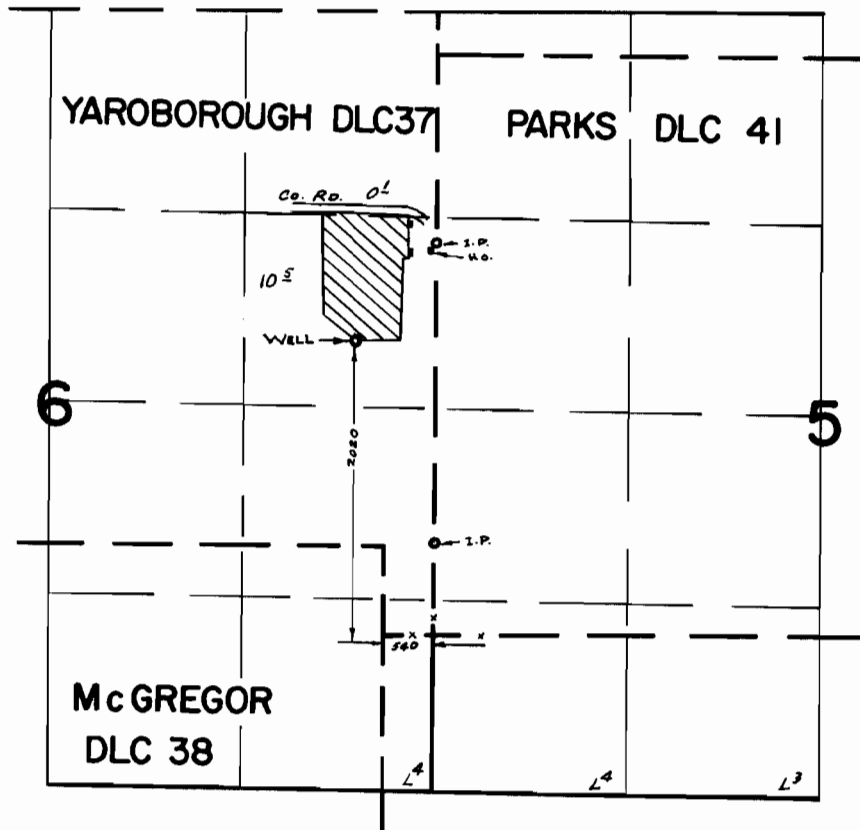

FINAL PROOF SURVEY UNDER

Application No. G-3425 Permit No. G-3211
IN NAME OF

ELDEN BIRKY

Surveyed May 7, 1970, by R. MUCKEN