


T.12S.R.1W.W.M.

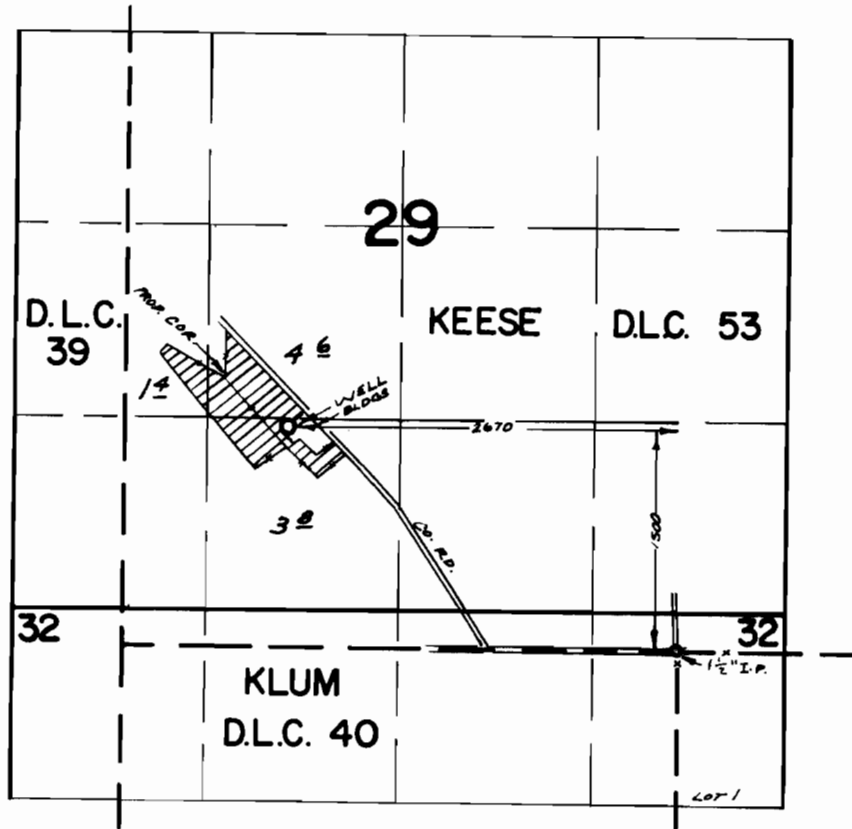

FINAL PROOF SURVEY UNDER

Application No. G-3159 Permit No. G-3356
IN NAME OF

HUBERT J. & JANICE GRIFFITHS

Surveyed JULY 8, 1970, by R. MUCKEN.