


T.I.S.R.2W.W.M.

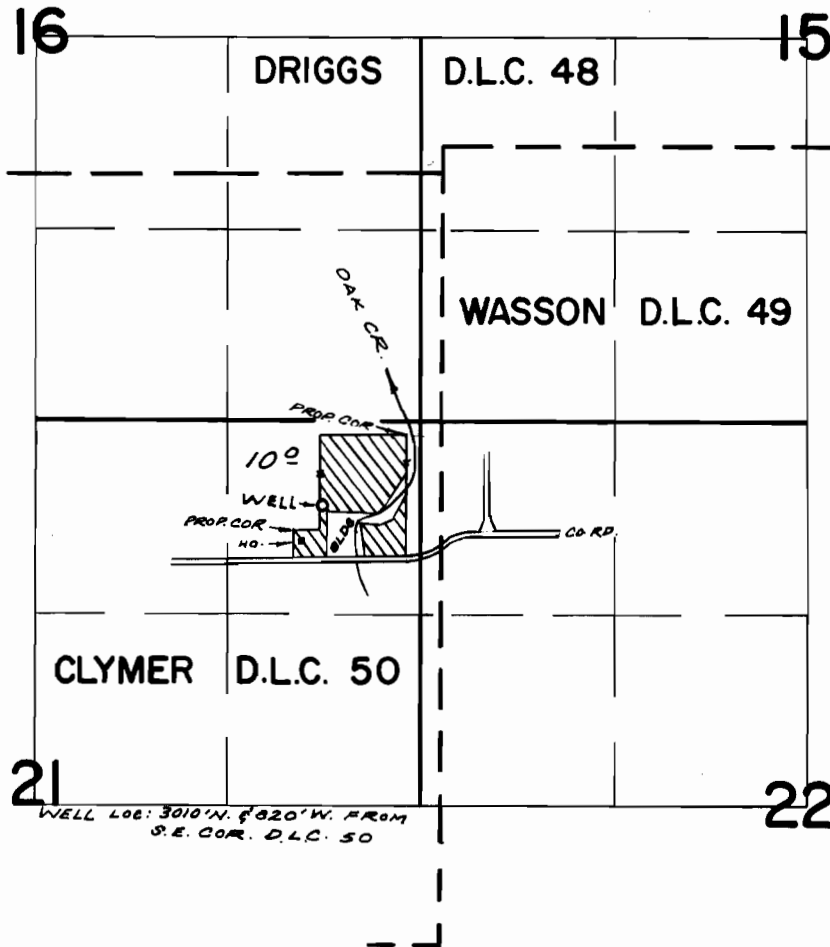

FINAL PROOF SURVEY UNDER

Application No. G-3633 Permit No. G-3416
IN NAME OF

IRA & MARYAN BECKLER

Surveyed MAY 29, 1970, by R. MUGGEN