


T.12S.R.2W.W.M.

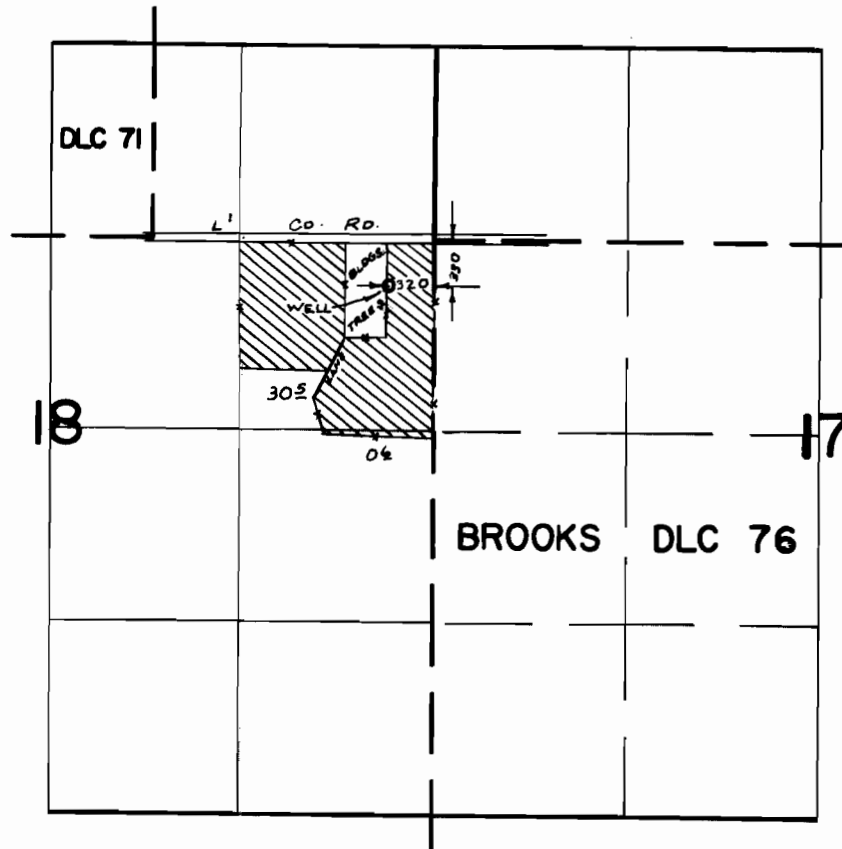

FINAL PROOF SURVEY
UNDER

Application No. G-4749 Permit No. G-4468
IN NAME OF

W. E. & DOROTHY I. ROBERTS

Surveyed MAY 6, 1970, by R. MUCKEN