


T.12S.R.2W.W.M.

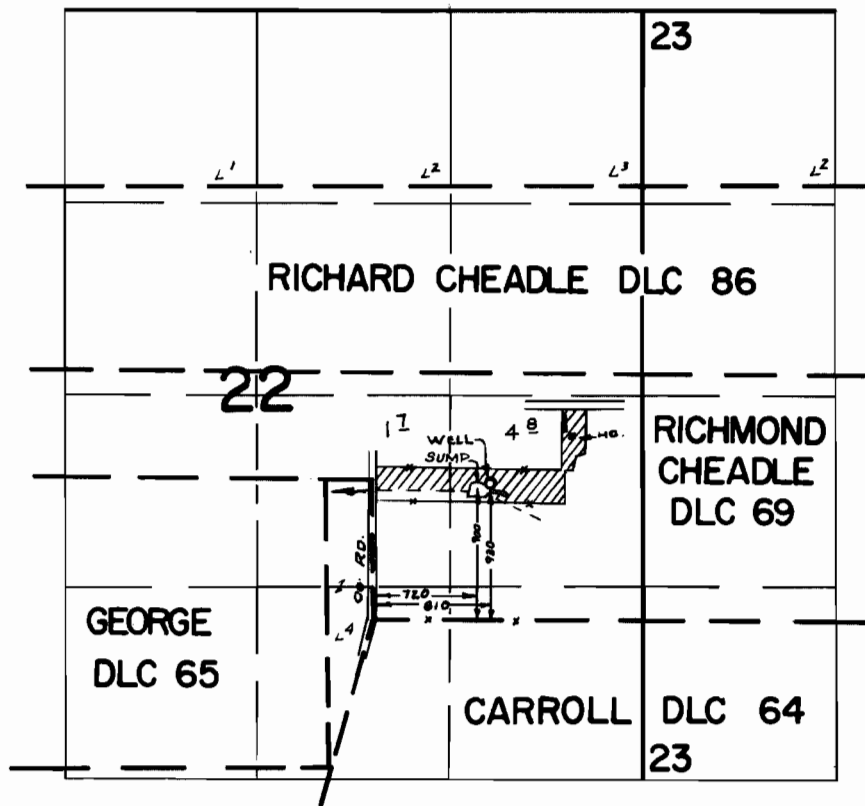

FINAL PROOF SURVEY
UNDER

Application No. G-3491 Permit No. G-3289
G-4399 G-4045
IN NAME OF
ROBERT E. & JUNE COLVIN &
WILLIAM R. & PATRICIA S. COLVIN

Surveyed MAY 6, 1970, by R. MUCKEN