


# T.14 S.R.1E.W.M.

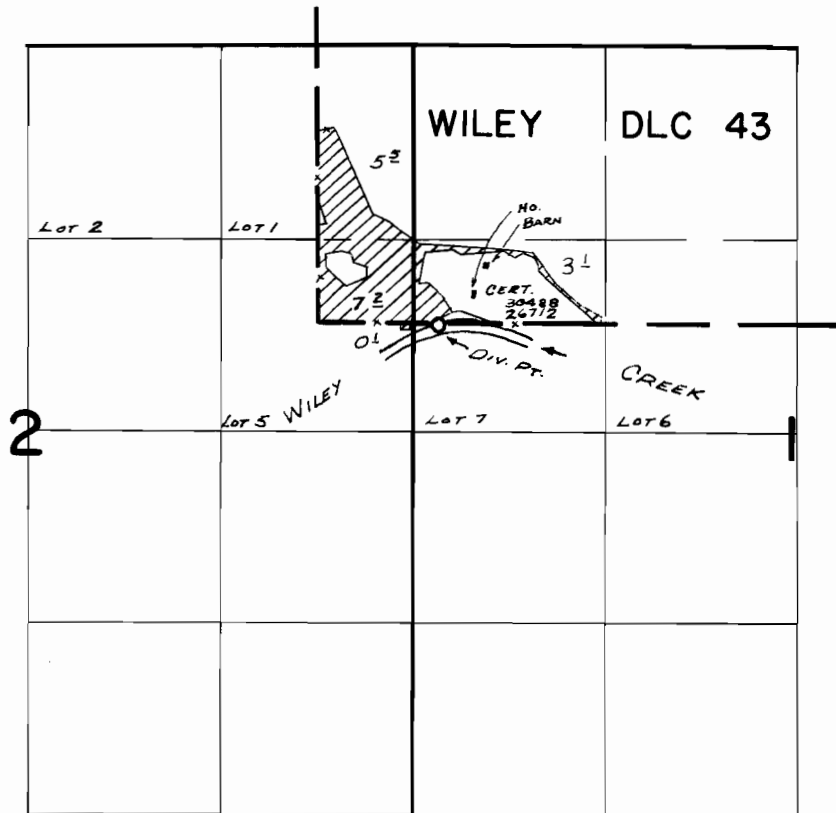

DIV. PT. LOCATED: 10' S. & 820' E. FROM S.W. COR. WILEY DLC 43

## FINAL PROOF SURVEY UNDER

Application No. 41282... Permit No. 30783...  
IN NAME OF

**WALTER & BETTY JO FORSBERG**

Surveyed MAR. 23, 1970, by R. MUCKEN...