


T.13S.R.3W.W.M.

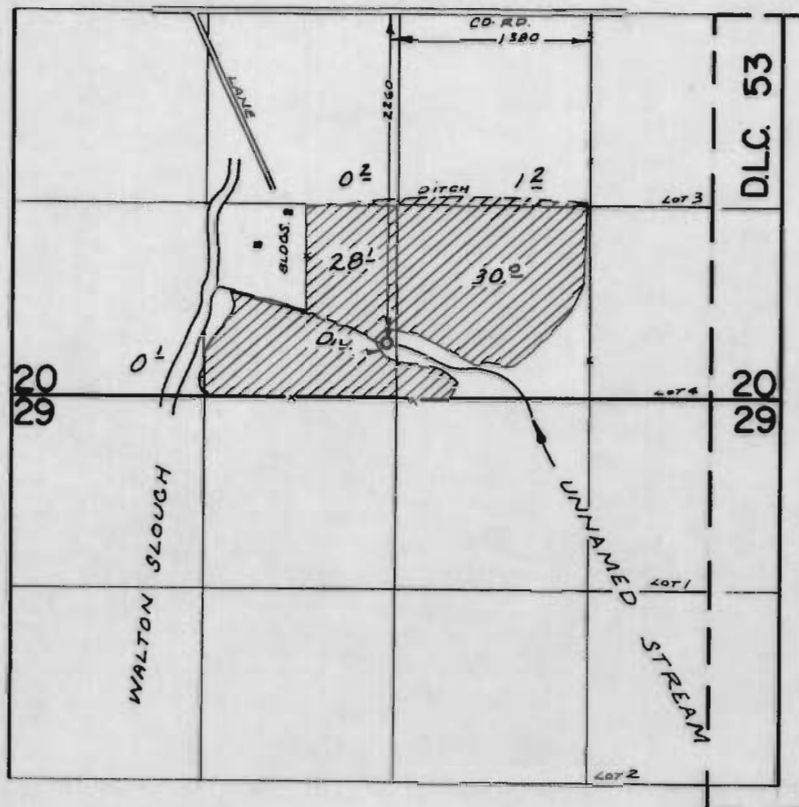

FINAL PROOF SURVEY
UNDER

Application No. 42111 Permit No. 31503
IN NAME OF

GENE D. MINTY

Surveyed JULY 28, 1970, by R. MUCKEN