


T.10S.R.2W.W.M.

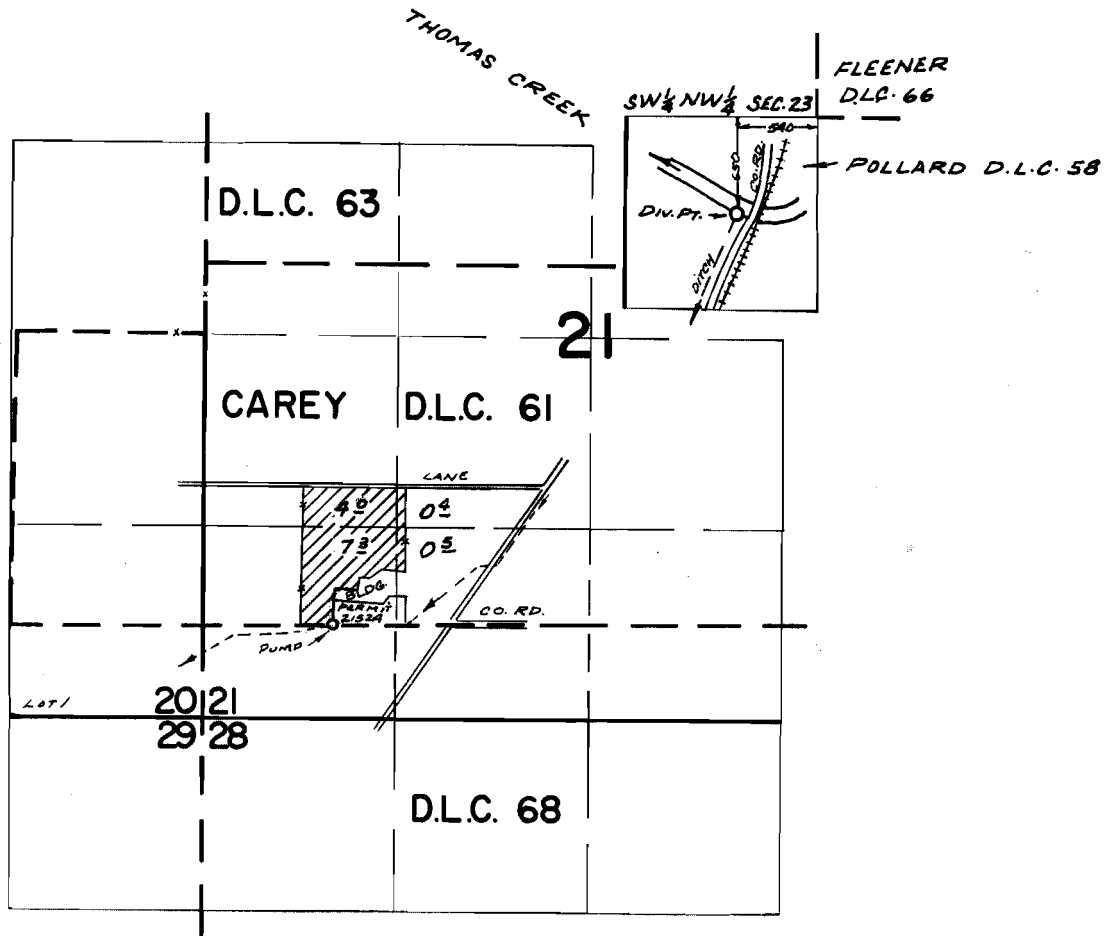

FINAL PROOF SURVEY UNDER

Application No. 44700 Permit No. 33467
IN NAME OF

RIVERVIEW DITCH ASSOCIATION

Surveyed APR. 22, 1970, by R. MUCKEN