


T.13S.R.1E.W.M.

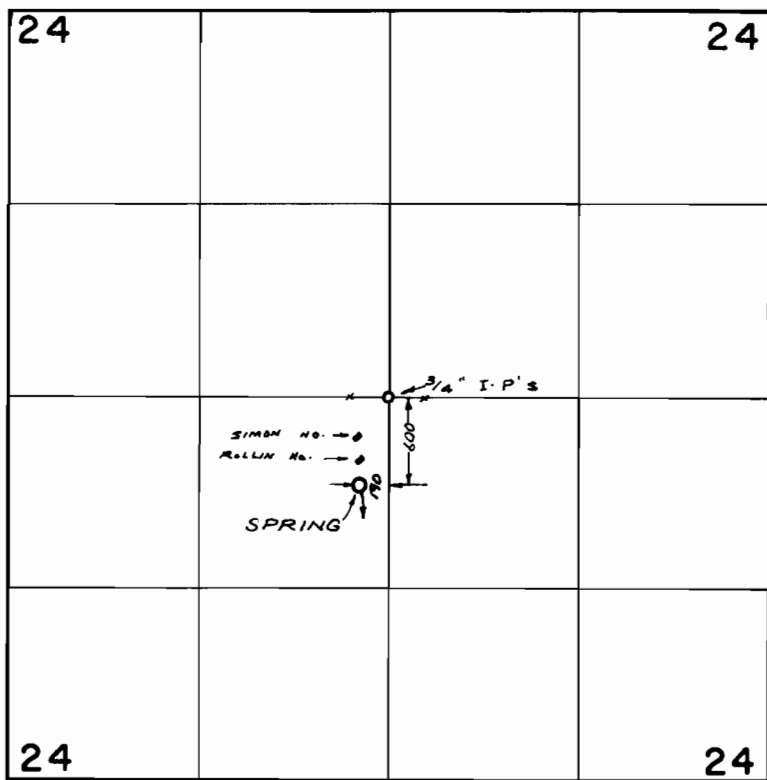

FINAL PROOF SURVEY
UNDER

Application No. 45414 Permit No. 33900

IN NAME OF
RACHEL M. & HARRY ROLLINS &
MARY M. & DARRELL SIMONS

Surveyed MAR. 24, 1970, by R. MUCKEN