


T.33S.R.42E.W.M.

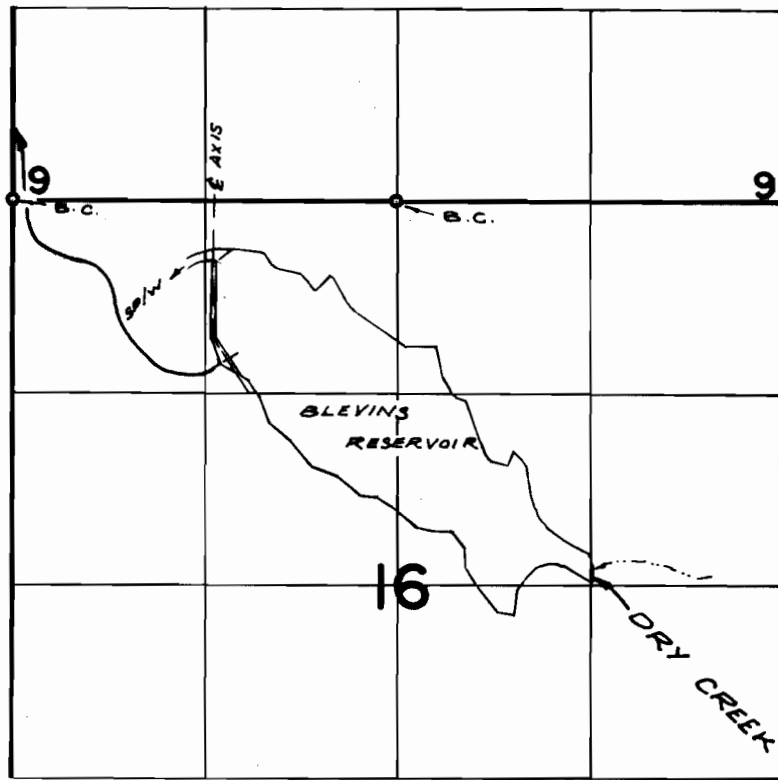

DIV. PT. LOC: 1170'W & 1090'S. FROM N. 1/4 COR. SEC. 16

FINAL PROOF SURVEY
UNDER

Application No. *R-28738* Permit No. *R-1527*
IN NAME OF

RALPH EASON

Surveyed *SEPT. 22, 1970*, by *R. MUCKEN*