


Range 11W, W.M.

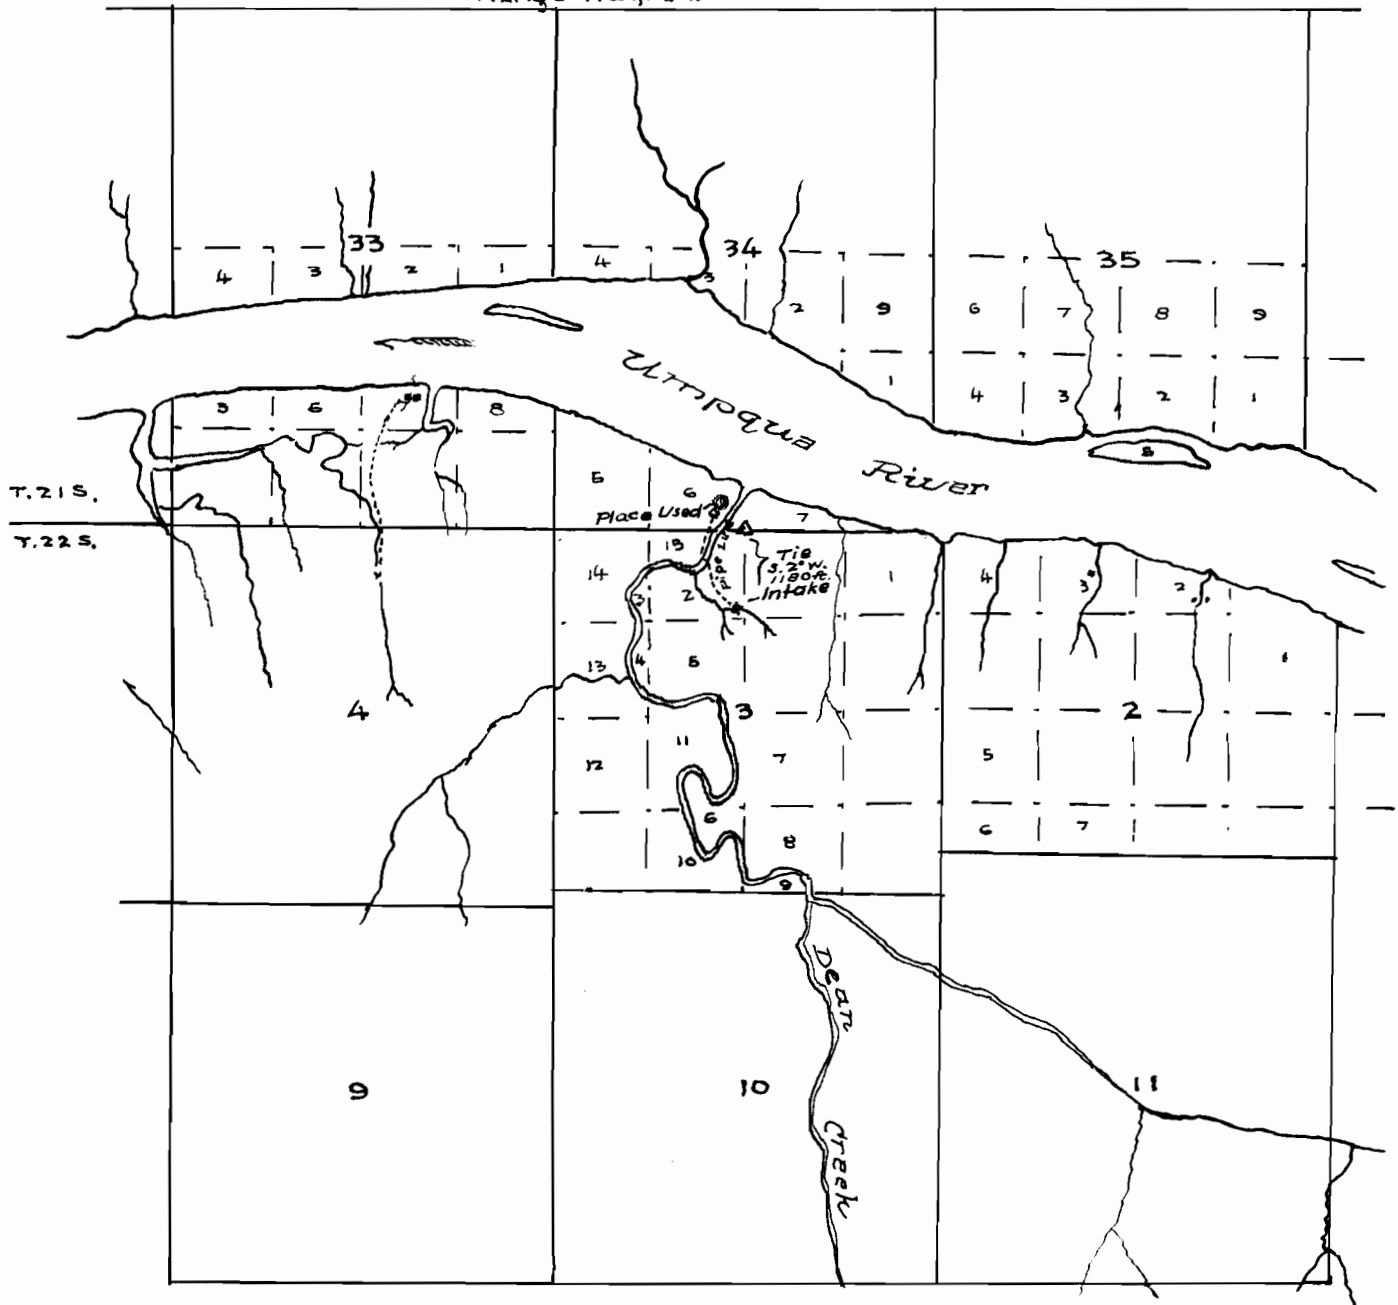

Scale $\frac{1}{2}$ Mi = 1-inch.

Map to
 Accompany Application
 for PERMIT
 to Appropriate WATER.

To the State Engineer
 Salem, Ore.

Application No. _____

Permit No. _____

I, E.L. Robinson of Reedsport, Ore., hereby certify that this map is made from notes of an actual survey made by me in May, 1921, and that it correctly represents the works described in the accompanying application, together with streams, etc in the vicinity.

E.L. Robinson
 (cert. 358) Surveyor

Application No 5230

Permit No 5369