


T.32 S.R.42 E.W.M.

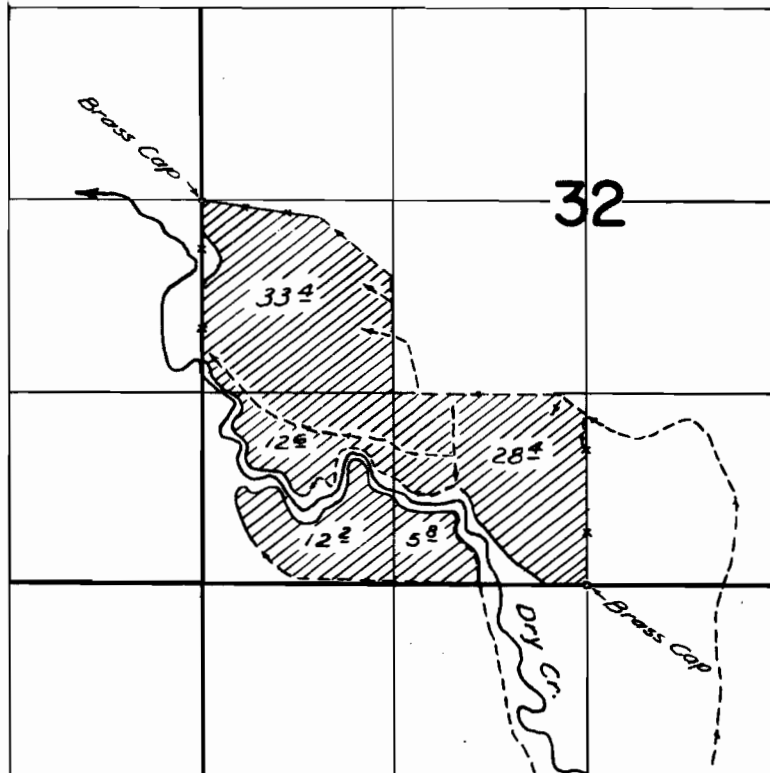

FINAL PROOF SURVEY

UNDER

Application No. 28740 Permit No. 22469

IN NAME OF

RALPH EASON

Surveyed 20 Oct 1961, by M. Bish