


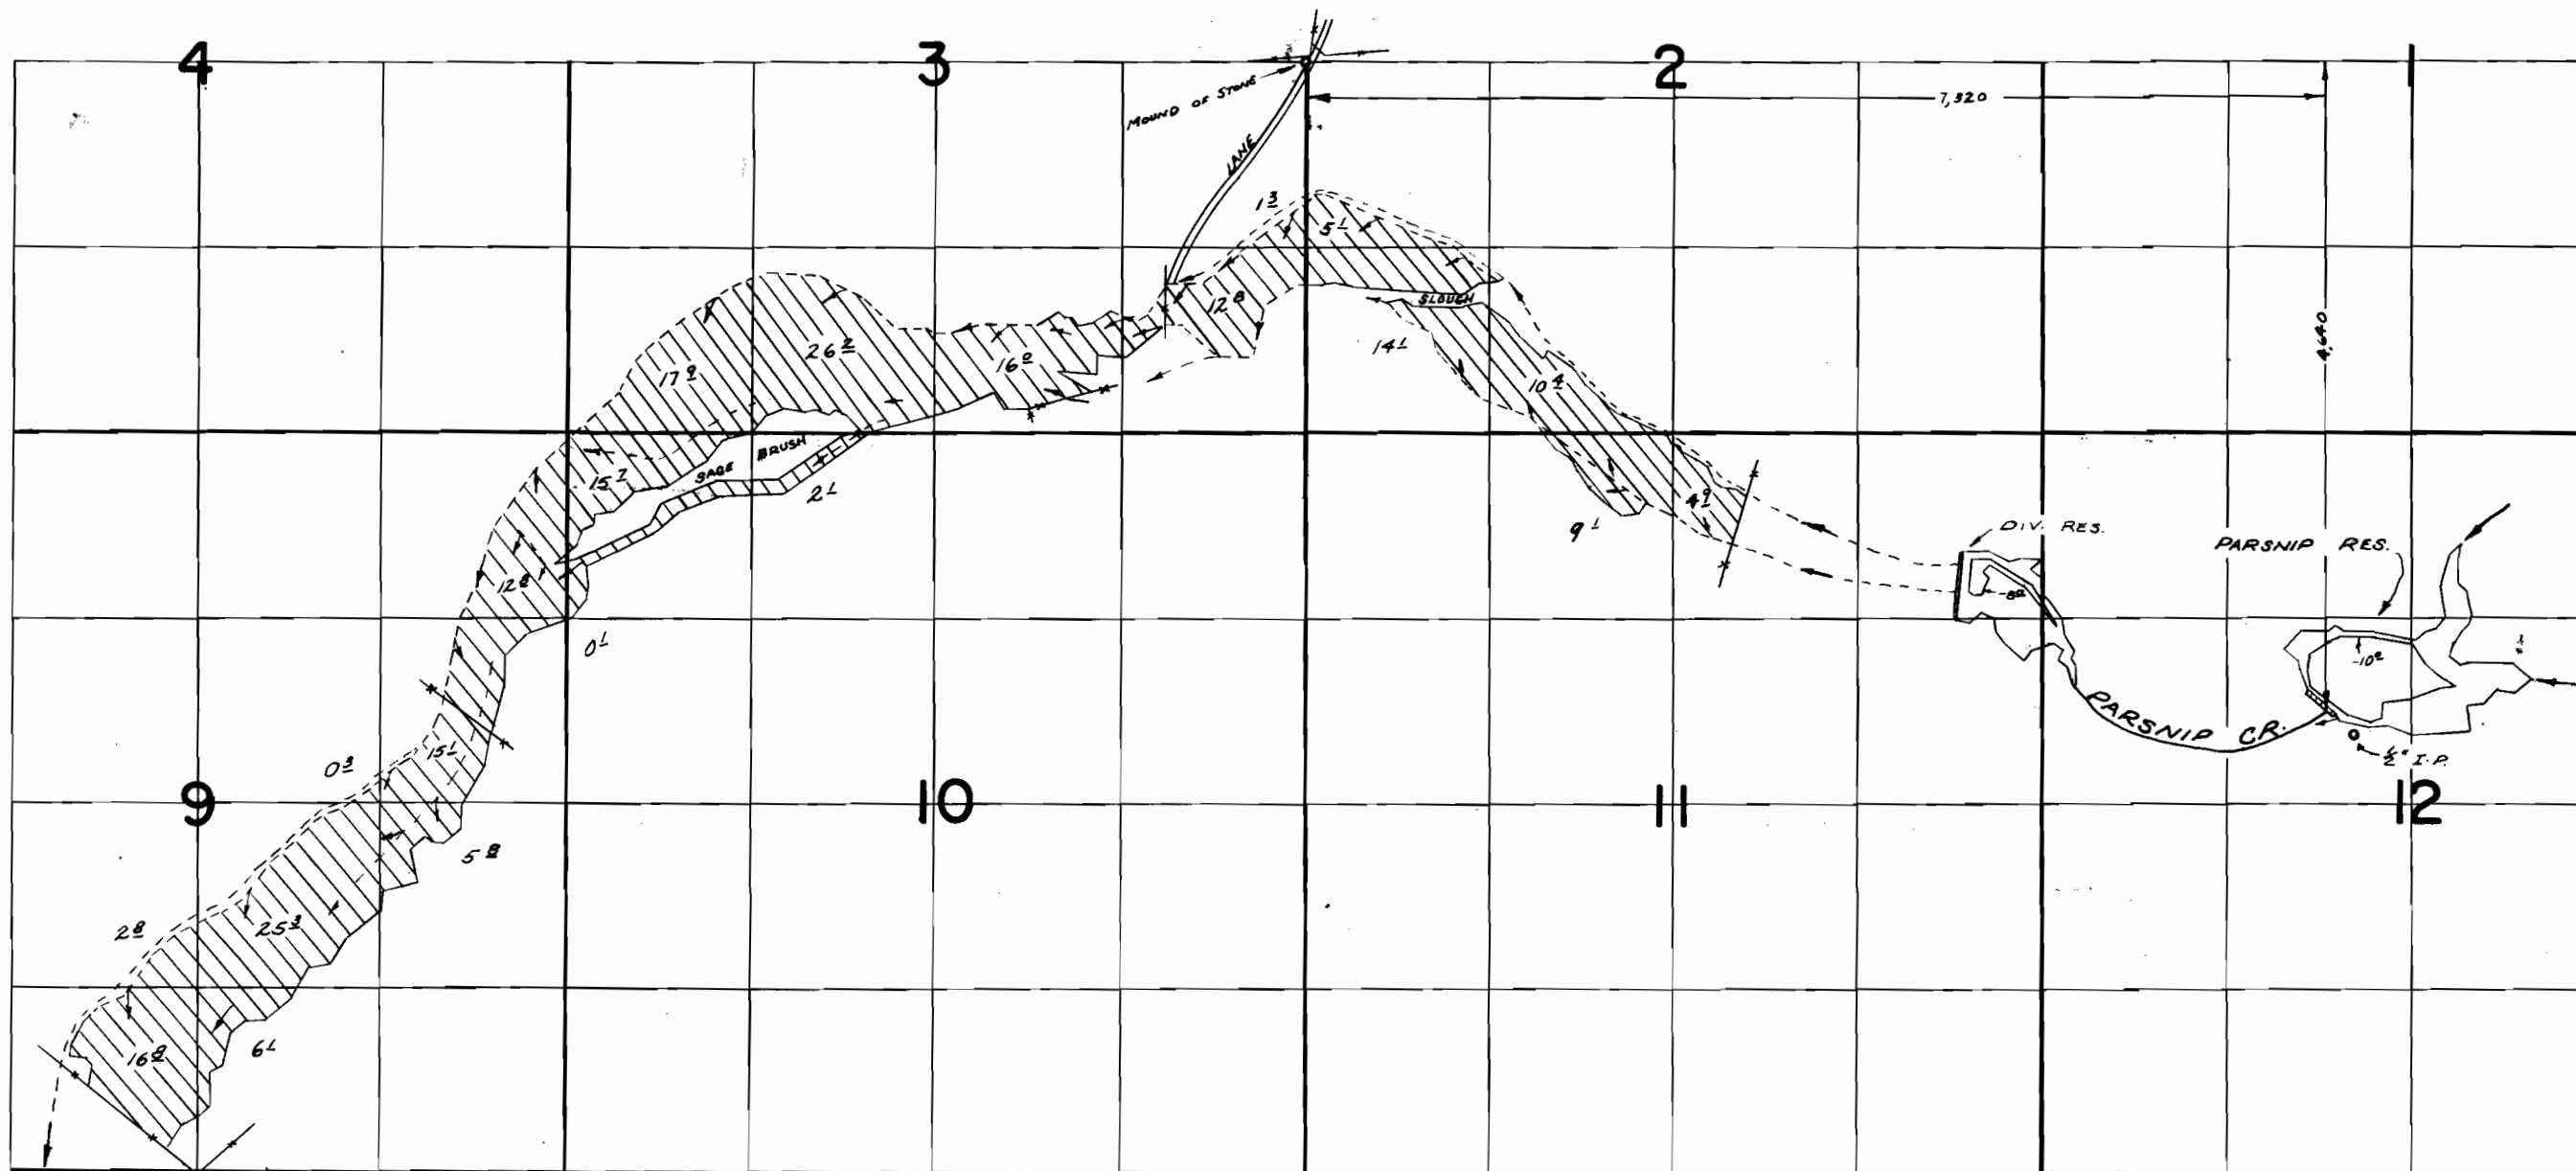

T.32S.R.45E.W.M.

FINAL PROOF SURVEY

UNDER

R-32917 R-2226
APPLICATION 32918 PERMIT 26016

JACA BROTHERS

SURVEYED SEPT. 25-29, 1970

BY R. MUCKEN