


T. 4 S. R. 1 W. W. M.

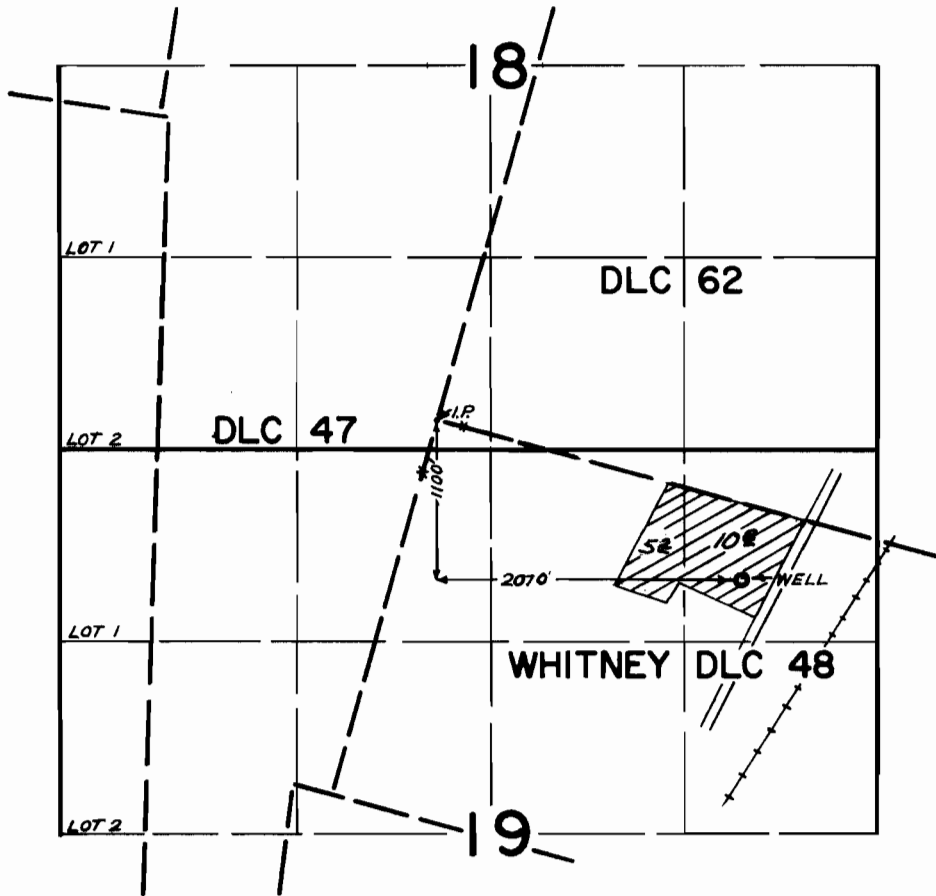

FINAL PROOF SURVEY
UNDER

Application No. G-3153 Permit No. G-2897
IN NAME OF

WAYNE M. COOK

Surveyed APR. 6 1971., by GREG BACA