


T. 8 S. R. 3 W. W. M.

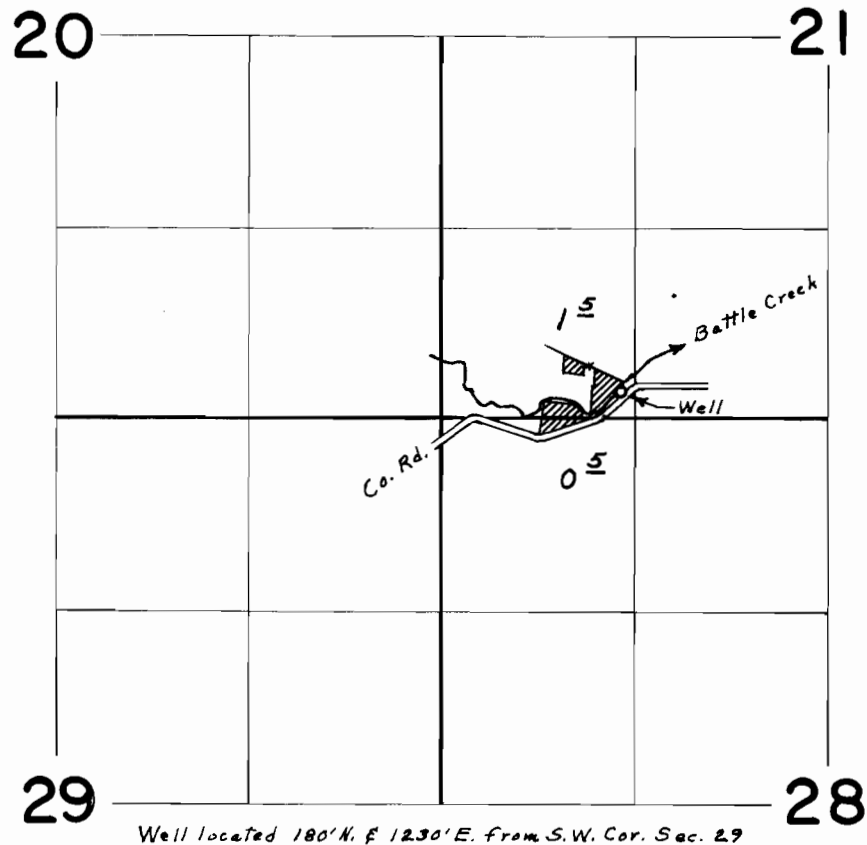

FINAL PROOF SURVEY
UNDER

Application No. G-3430 Permit No. G-3216
IN NAME OF

FLOYD E. BATES

Surveyed Sept. 24, 1970. by L. E. Gould