


T.8S.R.3W.W.M.

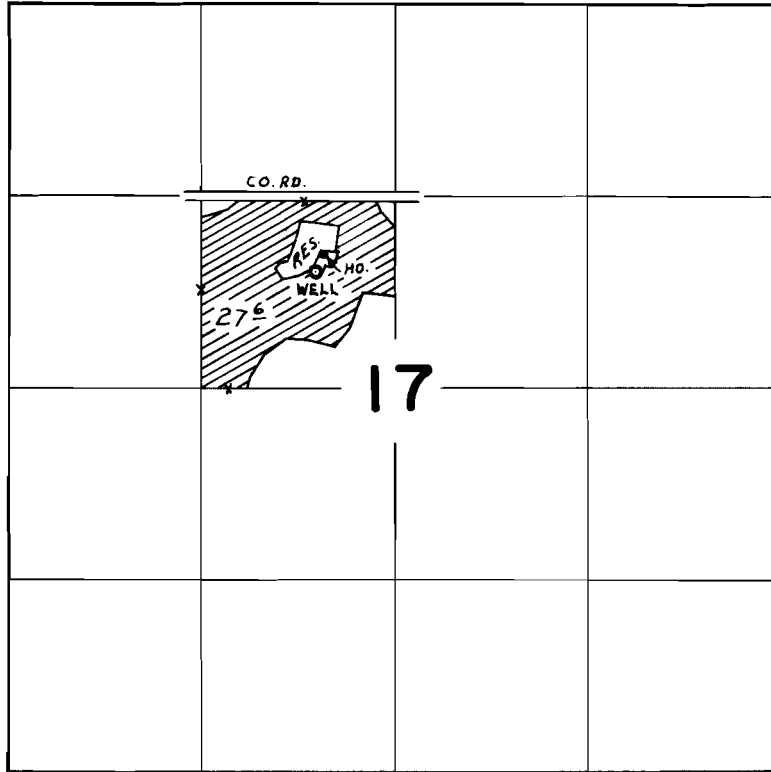

WELL LOC. 800' N. & 780' E. FROM SW COR. SE 1/4 NW 1/4 SEC. 17

FINAL PROOF SURVEY UNDER

Application No. G-8351 Permit No. G-3896
IN NAME OF

CAPITAL CITY TRANSFER CO.

Surveyed NOV. 9 1970, by L. E. GOULD