


T. 7 S. R. 1 W. W. M.

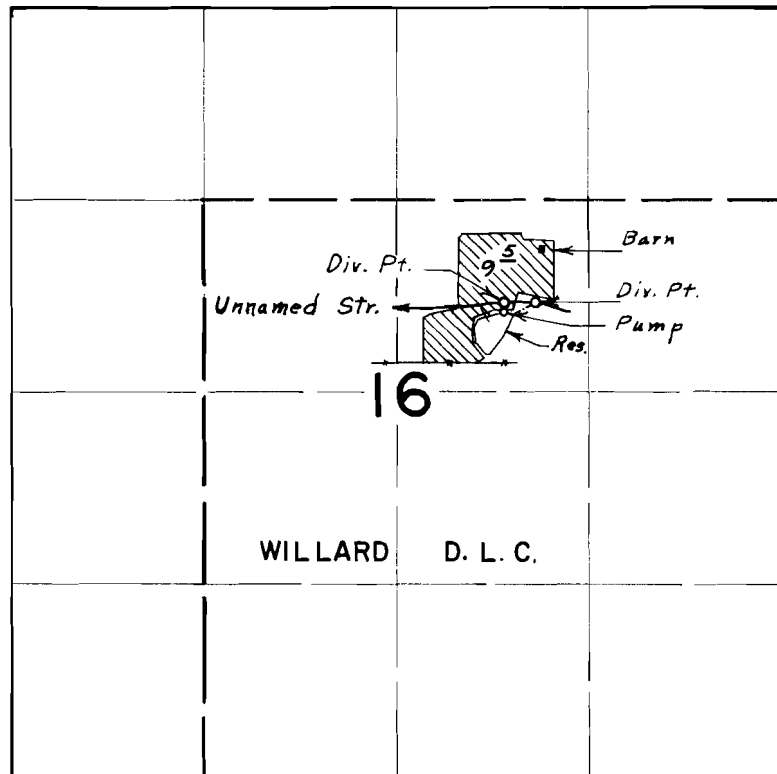

*Div. Pts. located: Str. 2020' S. & 3580' E.; 2036' S. & 3370' E.;
Res., 2120' S. & 3230' E.; all from N.W. Corner Section 16*

FINAL PROOF SURVEY
UNDER

R-37907 R-3969
Application No. 37908 Permit No. 29600
IN NAME OF
HARRY HUNEGS

Surveyed May 27 1970, by L. E. Gould