


T. 8 S. R. 3 W. W. M.

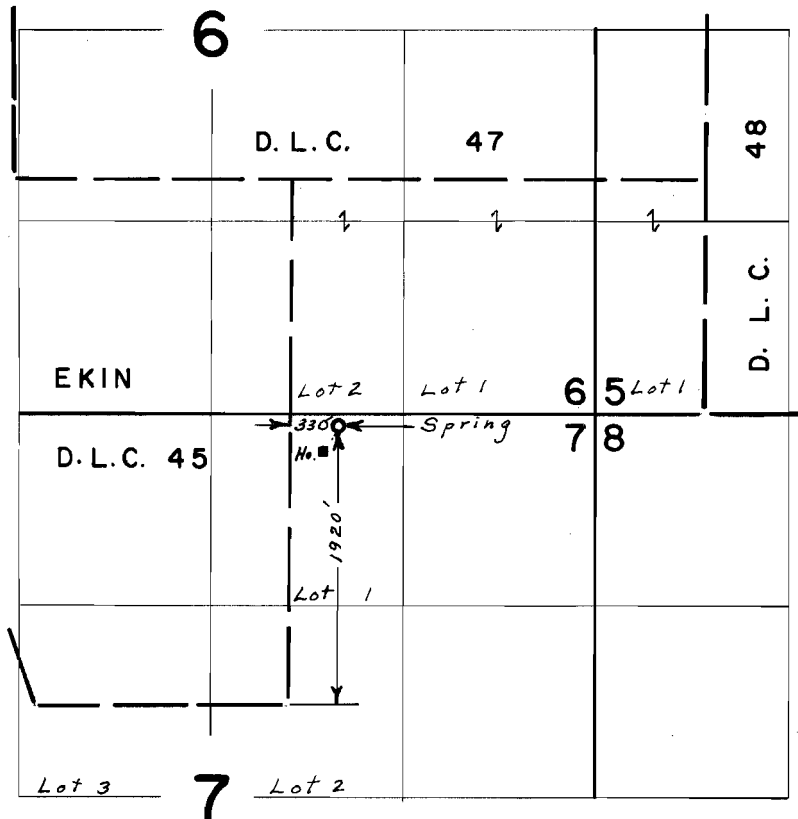

FINAL PROOF SURVEY UNDER

Application No. 44393 Permit No. 33242
IN NAME OF

W. S. RUSSELL

Surveyed Sept. 25, 1970, by L. E. Gould