


T.8&9S.R.4W.W.M.

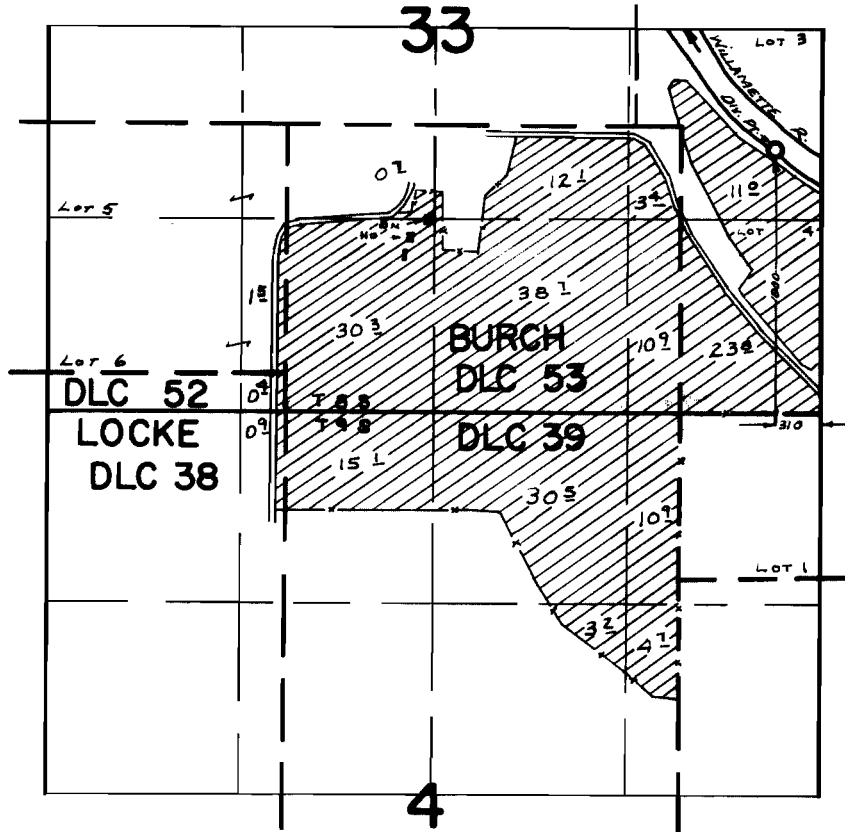

FINAL PROOF SURVEY
UNDER

Application No. 41968 Permit No. 31399
IN NAME OF

H. W. PEYREE

Surveyed Aug. 12., 1962., by D. Burch