


T.7S.R.5W.W.M.

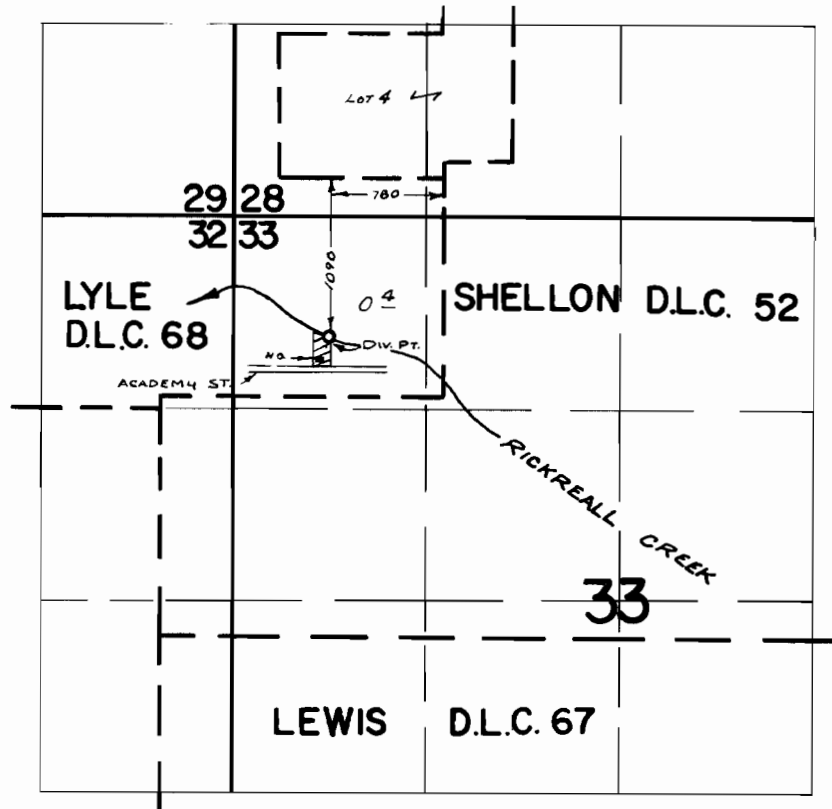

FINAL PROOF SURVEY  
UNDER

Application No. 42741      Permit No. 31923  
IN NAME OF

DONALD V. & AUDREY L. PETIT

Surveyed May 27, 1970, by R. MUCKEN.