P 32170 6
38184

# T.3&4S.R.18E.W.M.

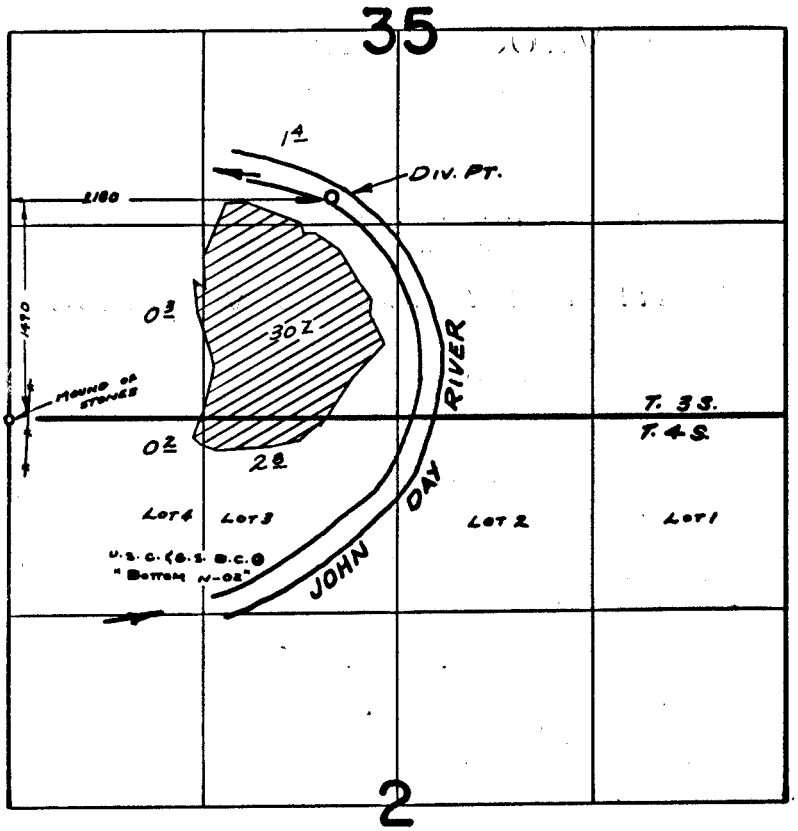


## FINAL PROOF SURVEY
UNDER

Application No. 43054 Permit No. 32170
IN NAME OF C. 38184

JAMES E. BROWN

Surveyed OCT. 23, 1970, by R. MUCKEN

1970-N