


T. 2 N. R. 13 E. W. M.

G-2942⁴

8

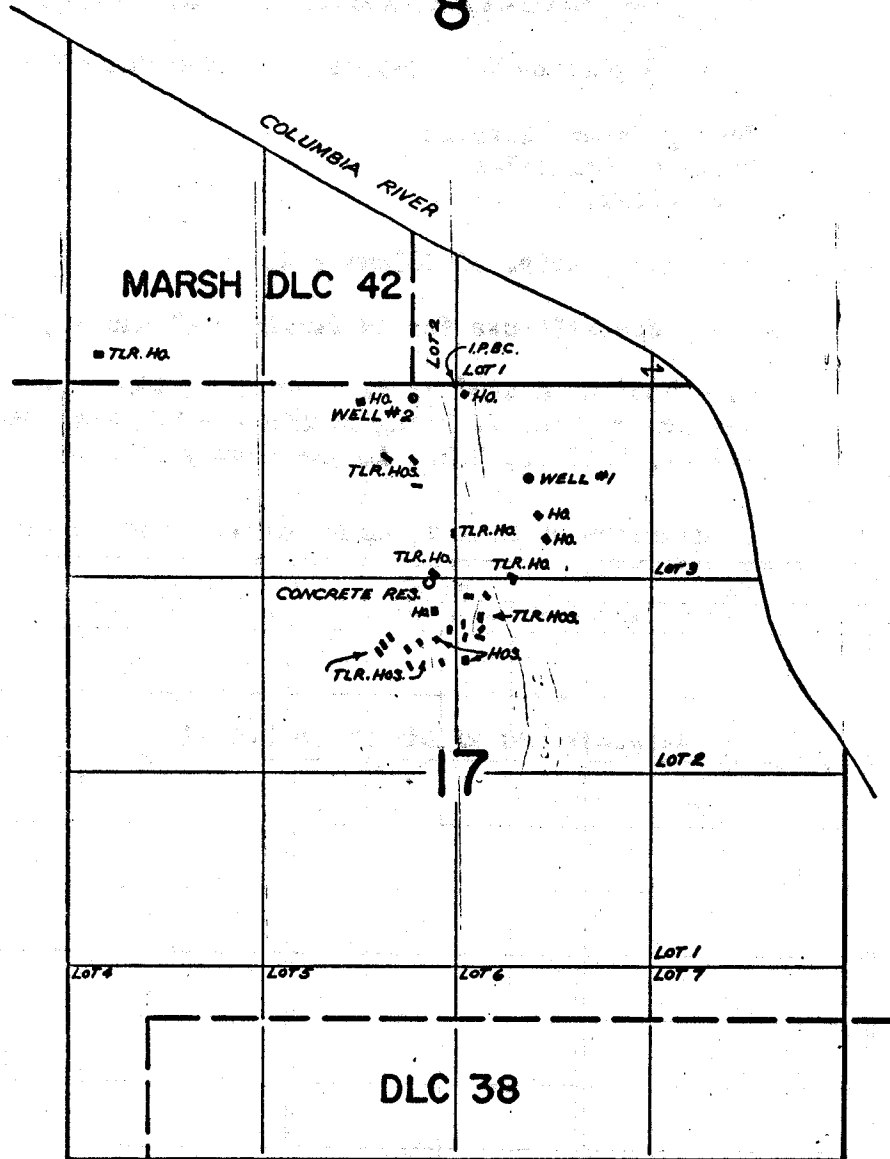

WELL #1 LOCATED 630'S. & 490'E. FROM N. 1/4 COR. OF SEC. 17
 WELL #2 LOCATED 80'S. & 280' W. FROM N. 1/4 COR. OF SEC. 17
 CONCRETE RES. LOCATED 1350'S. & 180' W. FROM N. 1/4 COR. OF SEC. 17

FINAL PROOF SURVEY
 UNDER

Application No. G-3204... Permit No. G-2942...
 IN NAME OF

TOOLEY WATER DISTRICT

Surveyed OCT. 21, 1970, by L. E. GOULD