


306174

T. 2 N. R. 13 E. W. M.

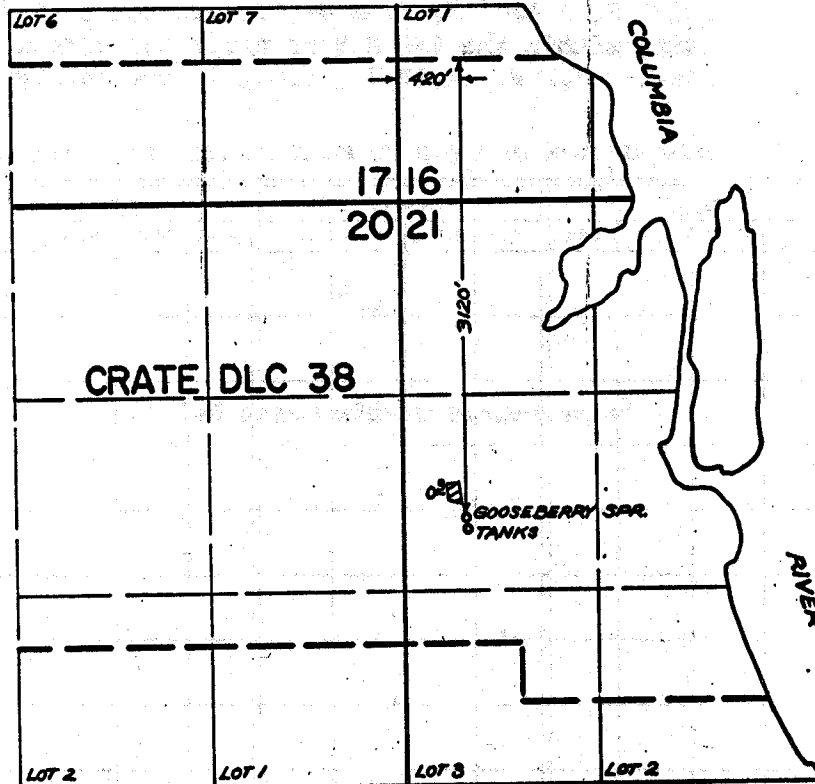

FINAL PROOF SURVEY UNDER

Application No. 41002..... Permit No. 30617.....
IN NAME OF

MOBILE ASSOCIATES, INC......

Surveyed OCT. 26... 1970., by L.E. GOULD.....