


# T.28&3N.R.12E.W.M.

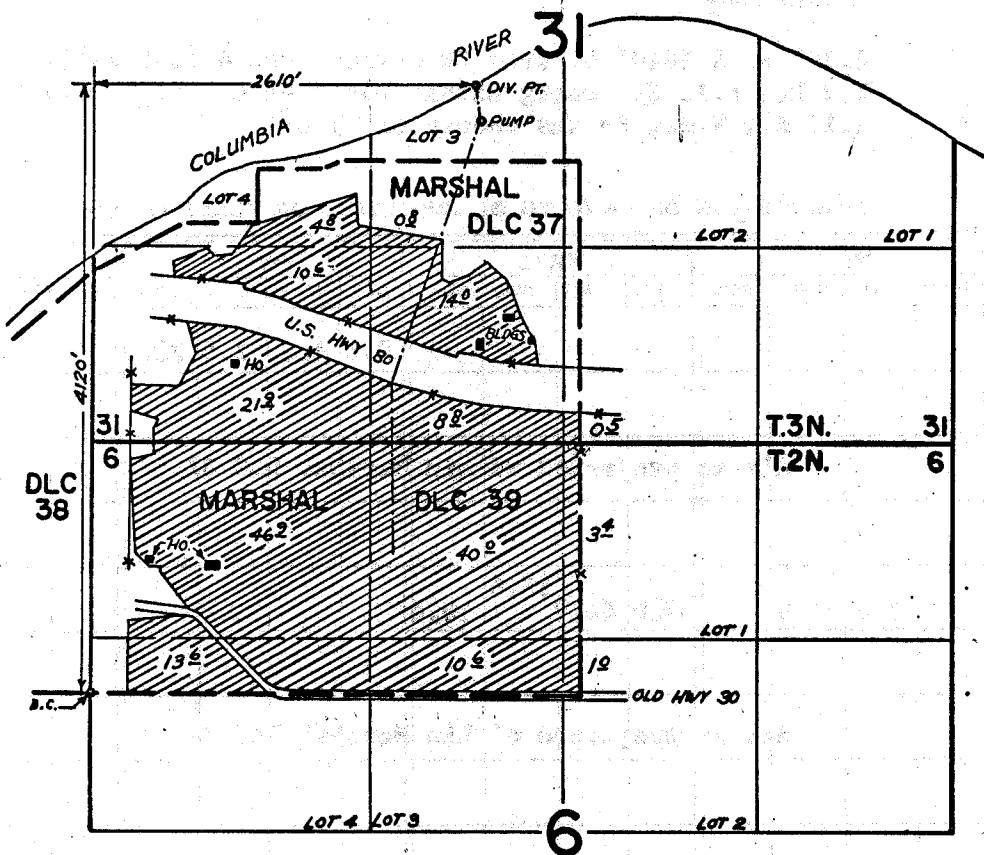

## FINAL PROOF SURVEY UNDER

Application No. 39475 Permit No. 29391  
 IN NAME OF  
**GRANT E. WILSON, MARK G. WILSON  
 & THE ESTATE OF FERN K. WILSON.**

Surveyed OCT. 20 1970, by L.E. GOULD