


# T. 1N.R. 4W. W.M.

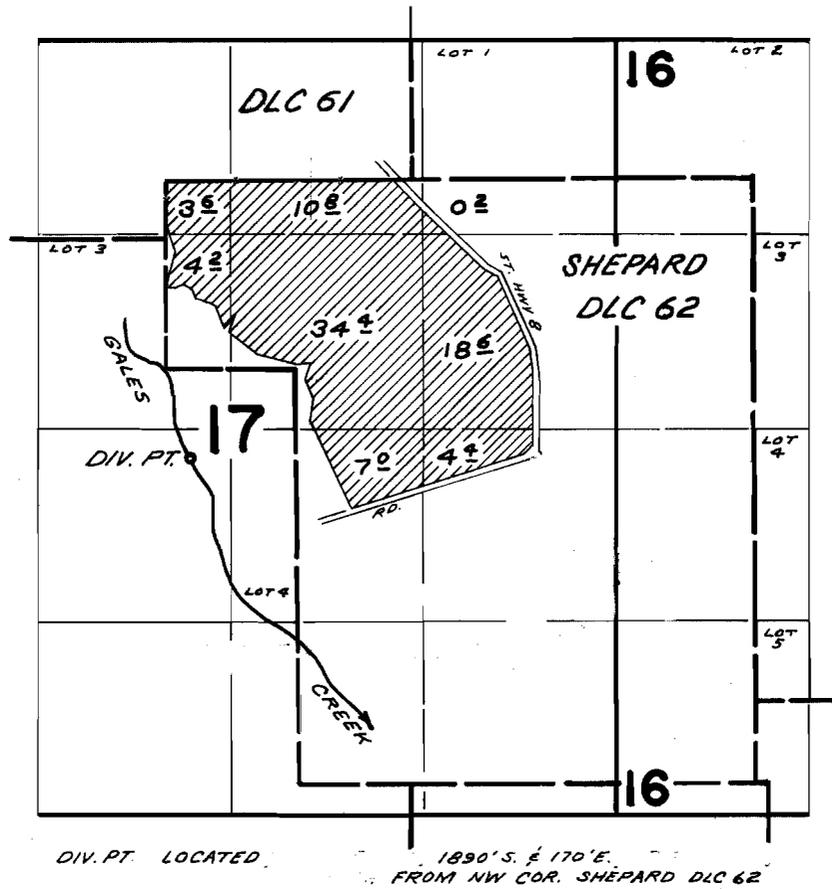

## FINAL PROOF SURVEY UNDER

Application No. 40820 Permit No. 30412  
IN NAME OF

CAMENZIND BROTHERS

Surveyed MAY 8 1969, by D. BUELL