


# T.8&9S.R.38E.W.M.

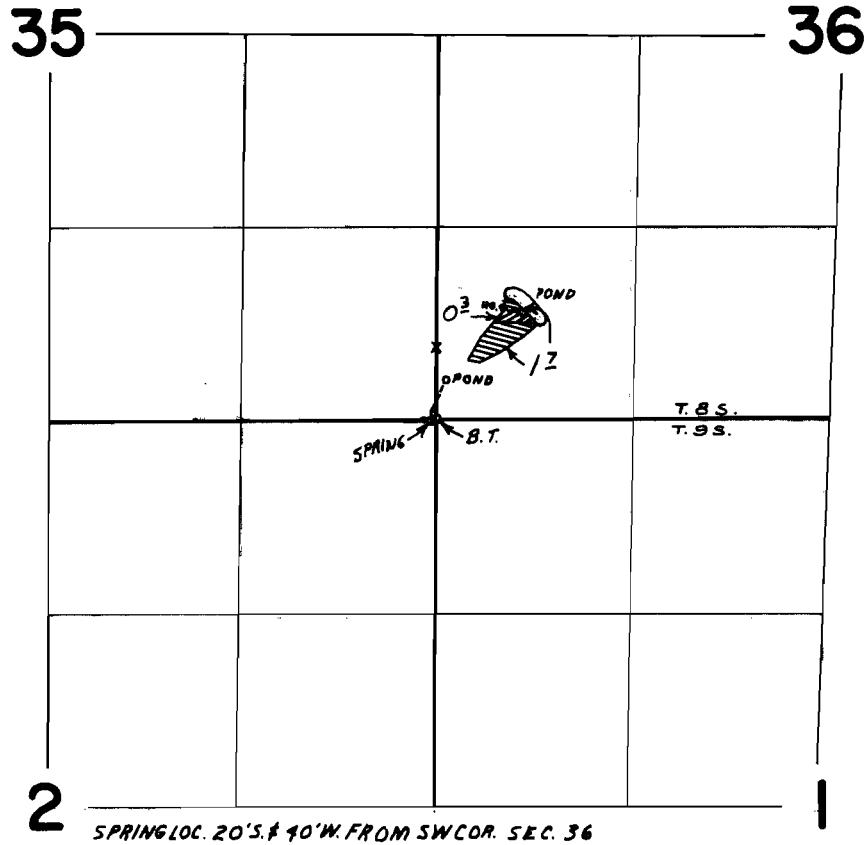

PRIMARY  
SUPPLEMENTAL P-1868; P-28630

## FINAL PROOF SURVEY UNDER

Application No. ~~12637~~ Permit No. ~~31816~~  
IN NAME OF

.....  
**WILLIAM F. HEIZER**  
.....

Surveyed JULY 20 1970, by L.E. GOULD.....