


T. 14 S. R. 5 W. W. M.

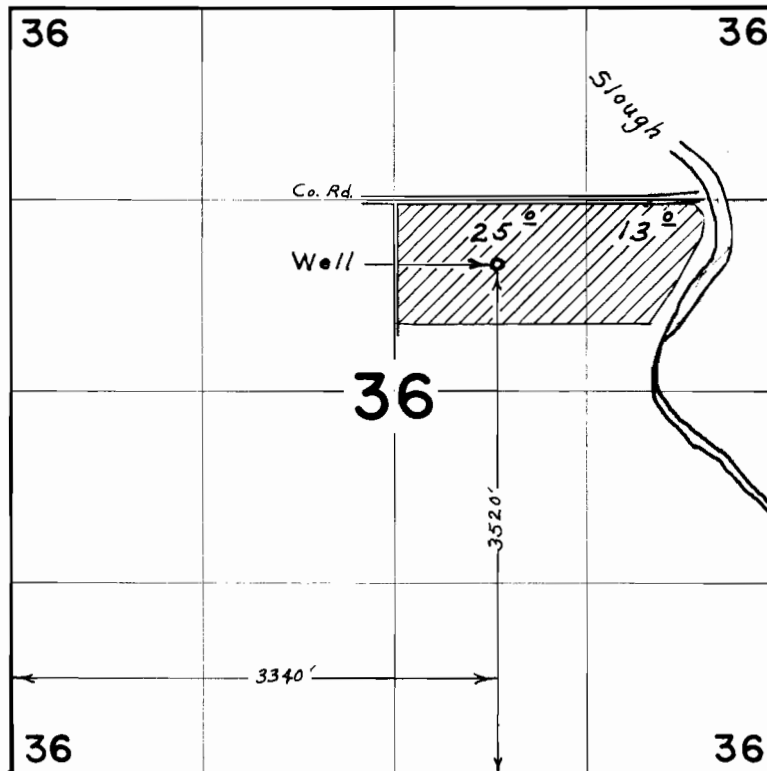

FINAL PROOF SURVEY

UNDER

Application No. **G-3405** Record No. **G-3194**

IN NAME OF

FLOYD GORACKE

Witnessed **May 7, 1970** by **L. E. Gould**