


T. 14 S. R. 5 W. W.M.

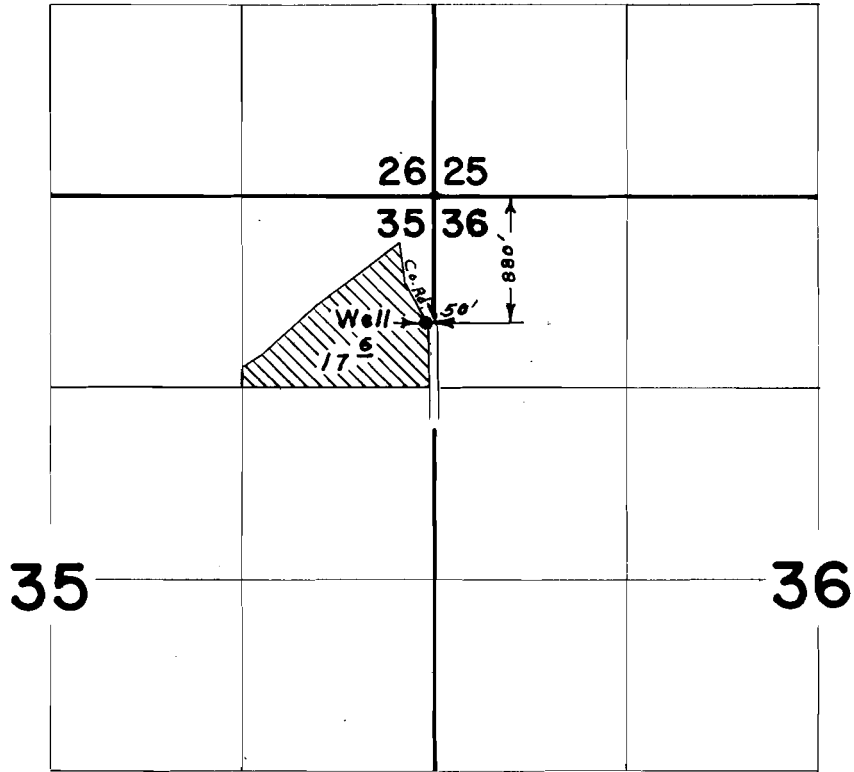

FINAL PROOF SURVEY

UNDER

Application No. G-4111 Permit No. G-3859

IN NAME OF

MRS. CLIFFORD E. GEORGE

Surveyed April 22, 1970, by L. E. Gould