


T.14 & 15S. R.5 W. W.M.

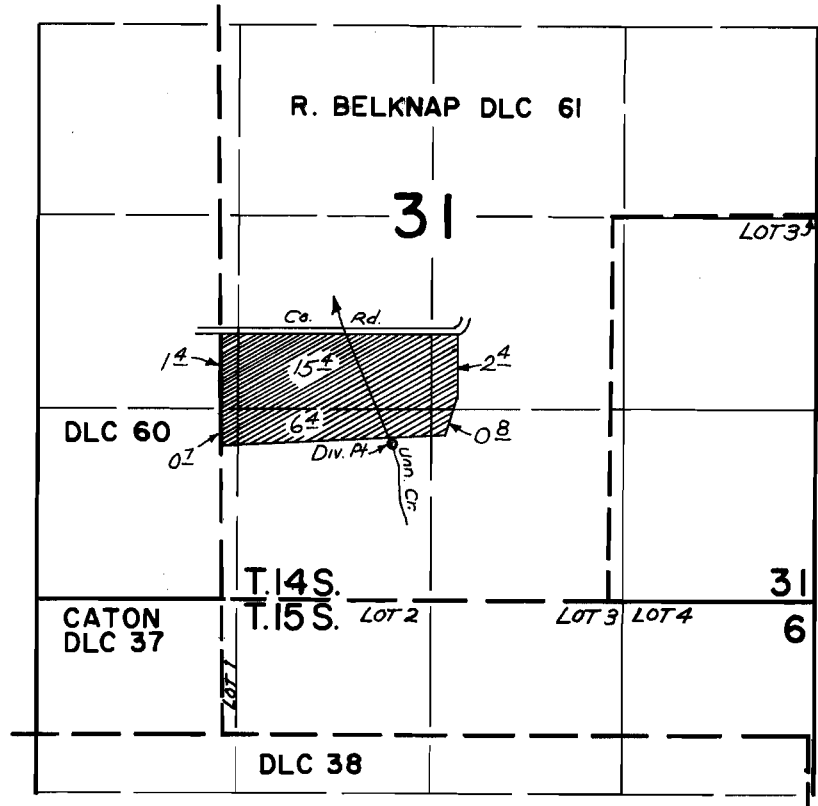

DIV. PT. LOC. 2010' N. & 1140' E. FROM SE COR. CATON DLC 37

FINAL PROOF SURVEY UNDER

Application No. 40973 Permit No. 30555
IN NAME OF

PAUL N. and/or PATRICIA A. HURNS

Surveyed SEPT. 8, 1970, by L. E. GOULD