


T. 15 S. R. 5 W. W. M.

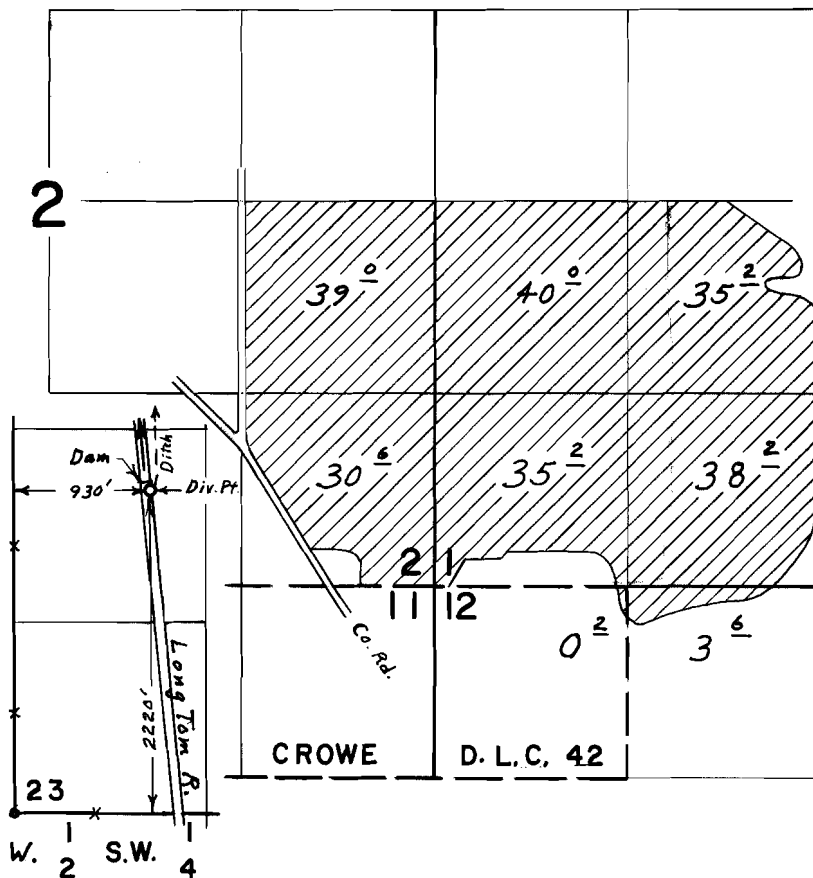

FINAL PROOF SURVEY UNDER

Application No. 44571 Permit No. 33362
IN NAME OF

DAN TRACER

Surveyed Aug. 25, 1970, by L. E. Gould