


T.5S. R.I.E. W.M.

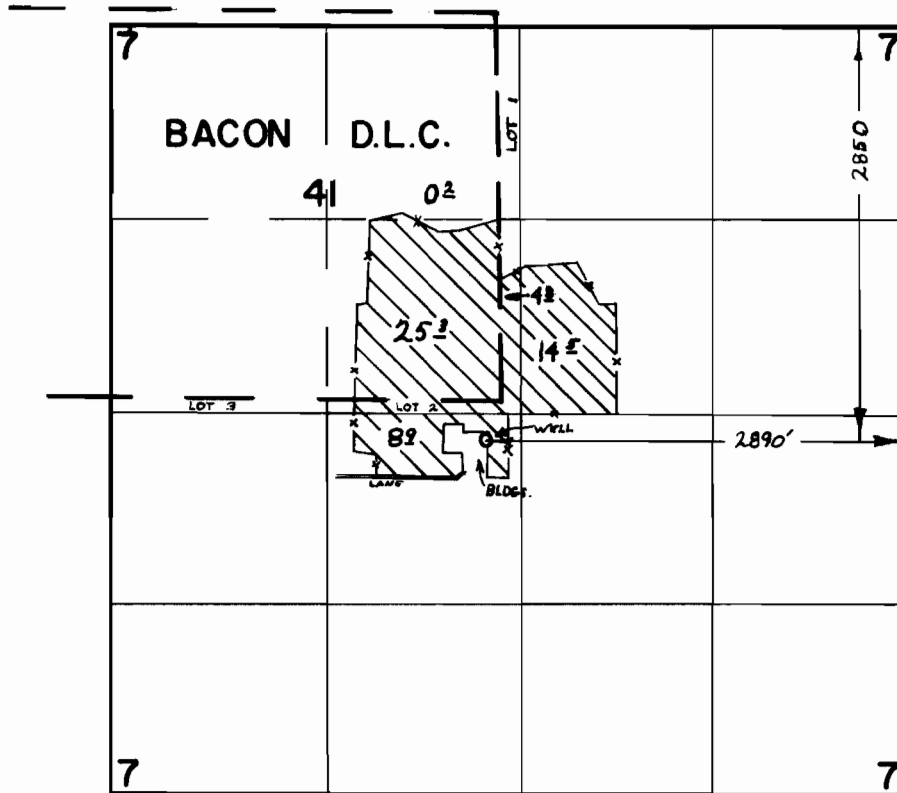

FINAL PROOF SURVEY UNDER

Application No. G-3505. Permit No. G-3301.
IN NAME OF

.....GEORGE YODER.....

Surveyed APR. 7, 1971, by R. MUCKEN.....