


T.5S.R.1E.W.M.

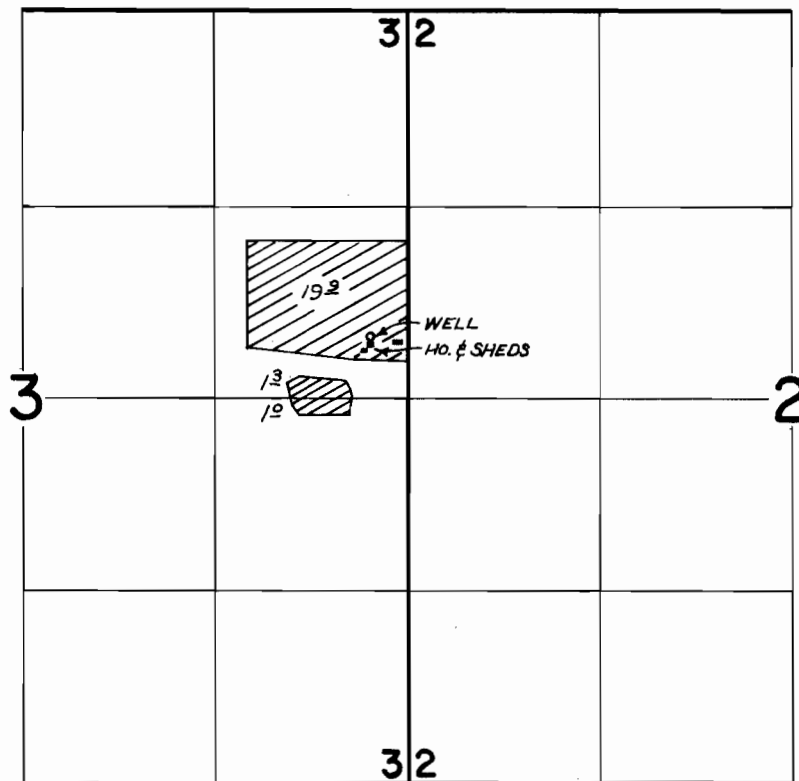

WELL LOCATED 2250'S. & 260'W. FROM NE COR. OF SEC. 3

FINAL PROOF SURVEY
UNDER

Application No. G-3537 Permit No. G-3329
IN NAME OF

CHARLES BOND

Surveyed OCT. 2 1970, by L.E. GOULD