


T. 3 S. R. 2 E. W. M.

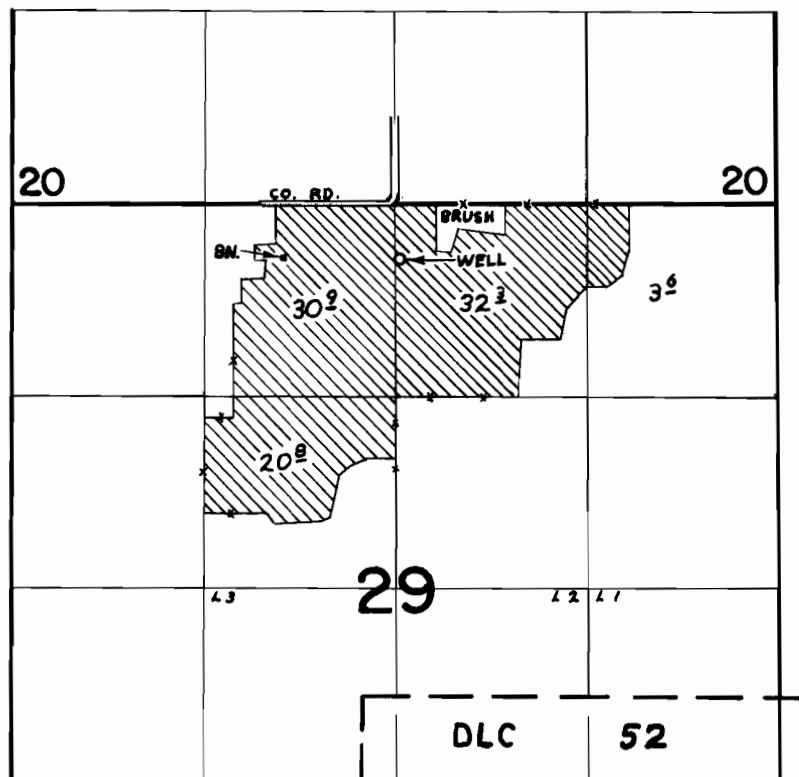

WELL LOC. 950' N & 30' E FROM SW COR. NW 1/4 NE 1/4 SEC. 29

FINAL PROOF SURVEY
UNDER

Application No. G. 4035 Permit No. G. 3784
IN NAME OF

ELDON EVANS

Surveyed SEP. 9 & 27 1971, by R. MUCKEN