


# T. I. S. R. I. E. W. M.

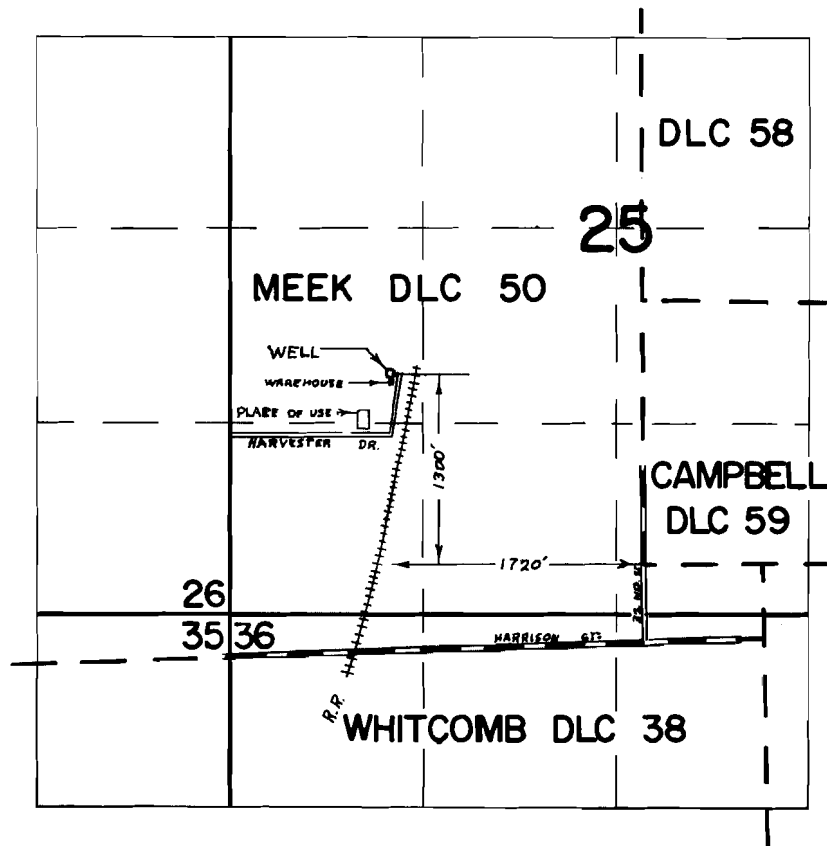

## FINAL PROOF SURVEY UNDER

Application No. G-5116..... Permit No. G-4885..  
IN NAME OF

.....CLINTON C. WARREN.....

Surveyed SEP. 29, 1971., by R. MUCKEN.....