


T.2S.R.3E.W.M.

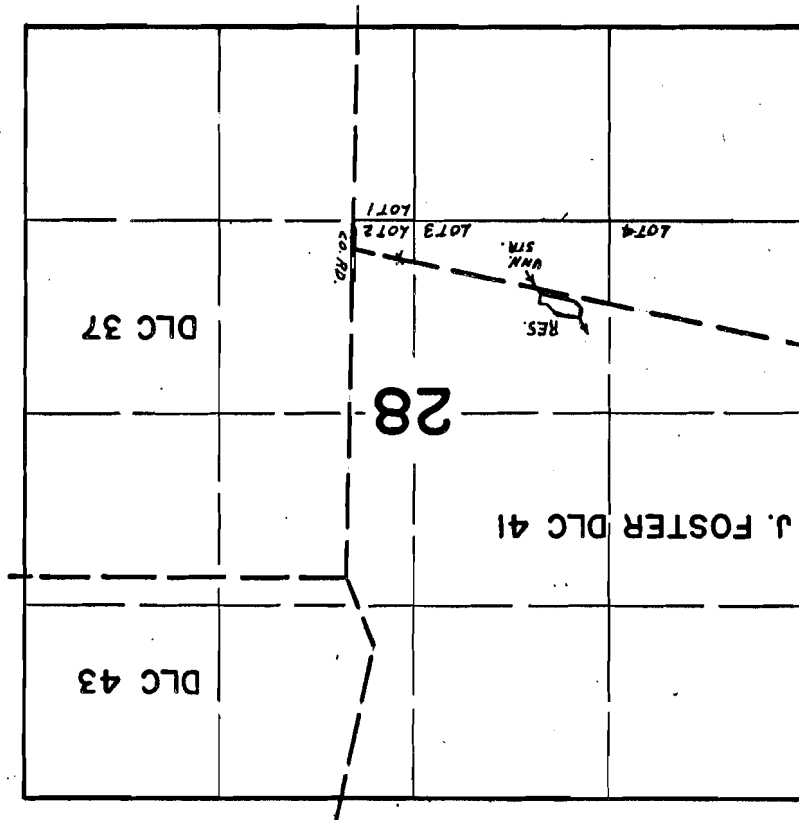

FINAL PROOF SURVEY

UNDER

Application No. ~~R-39164~~ Permit No. ~~R-3878~~
29188

IN NAME OF

~~RICHARD MARTELL~~

Surveyed ~~OCT 2~~ 19 ~~70~~, by ~~G. BACH~~