


T. 3 S. R. 1 W. W. M.

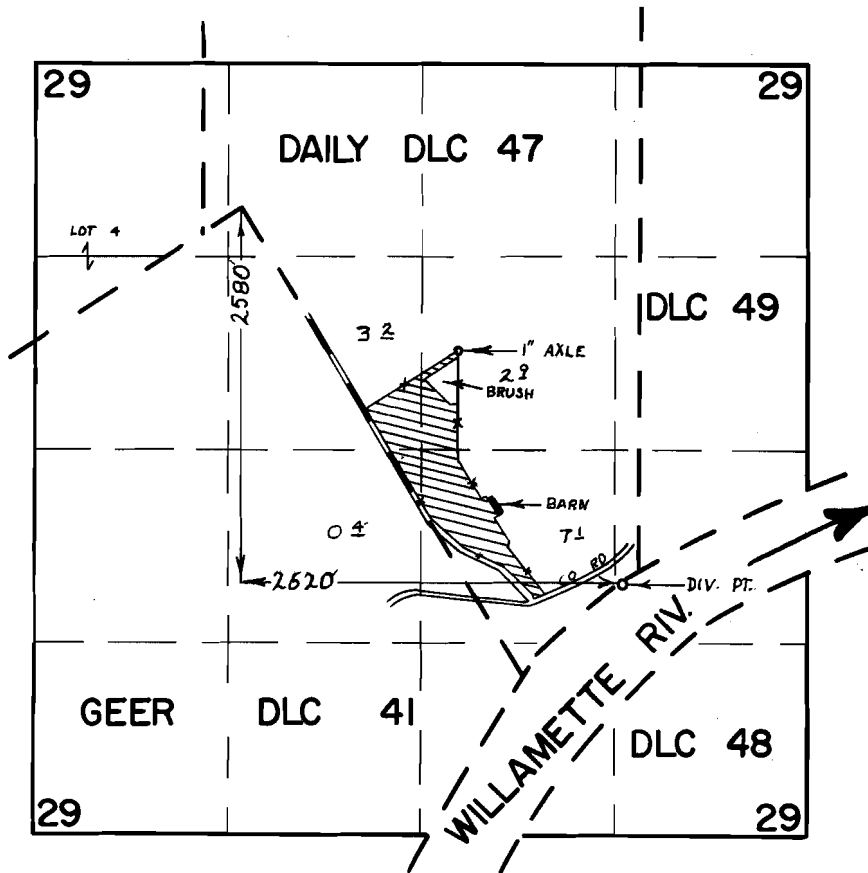

FINAL PROOF SURVEY UNDER

Application No. 40479 Permit No. 30165
IN NAME OF

JESS W. McNIEL

Surveyed JUNE 2, 1971, by R. MUCKEN