


T.4S.R.2E.W.M.

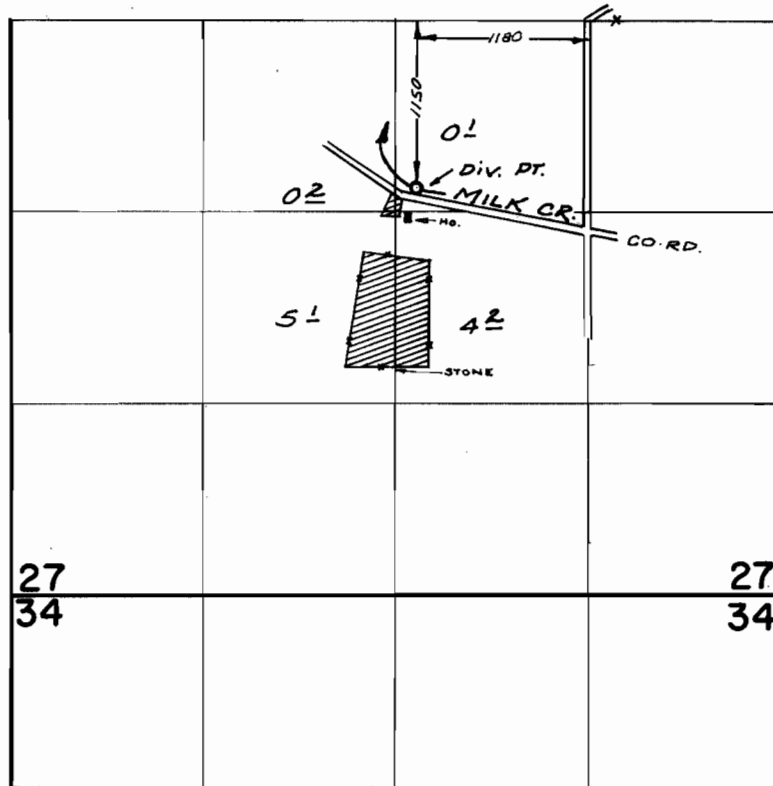

FINAL PROOF SURVEY UNDER

Application No. 42920 Permit No. 32069
IN NAME OF

J. L. HOWARD

Surveyed APR. 27, 1971, by R. MUCKEN