


T. 4 S. R. 3 E. W. M.

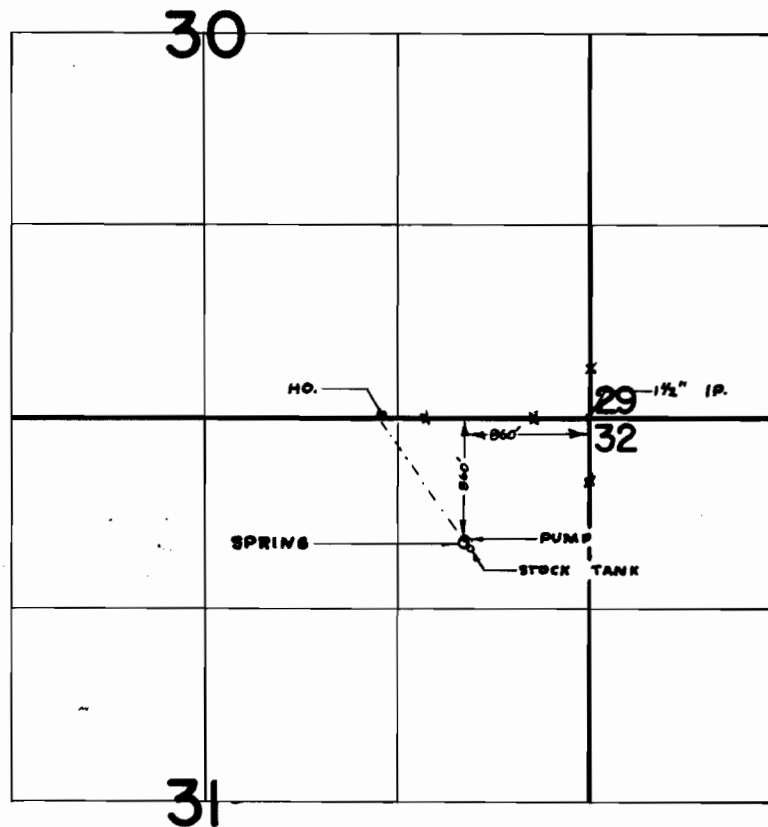

FINAL PROOF SURVEY
UNDER

Application No. 43437 Permit No. 32475
IN NAME OF

BERTHA RING

Surveyed APR. 30, 1971, by R. MUCKEN