


T. 6 N. R. 10 W. W. M.

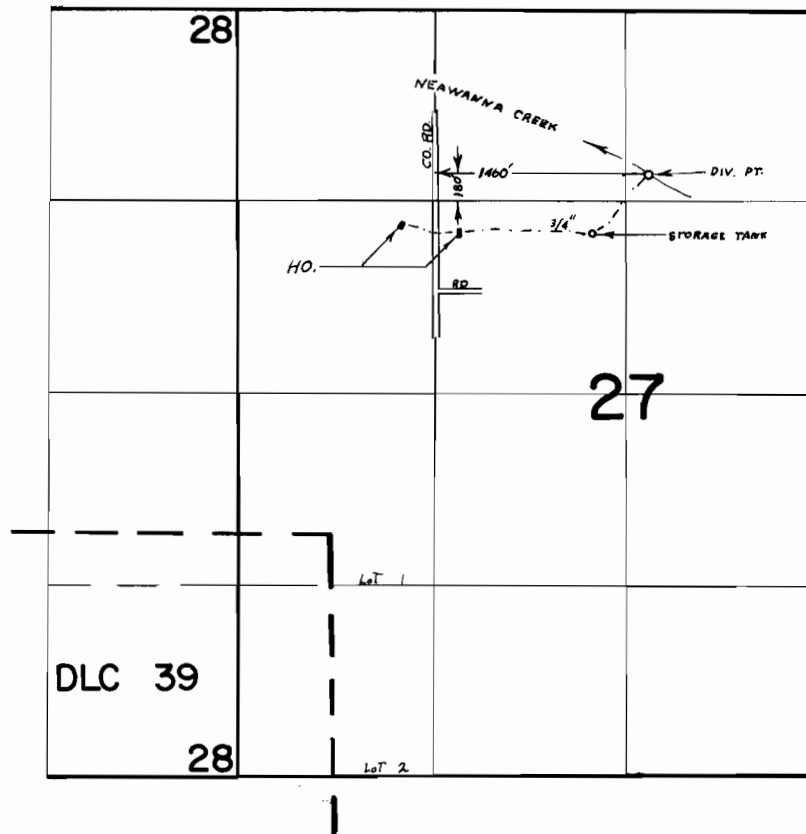

FINAL PROOF SURVEY
UNDER

Application No. 39827 Permit No. 29595
IN NAME OF

W. E. PALMROSE

Surveyed JUNE 11, 1971, by R. MUCKEN