


T 5 N. R 7 W. W. M.

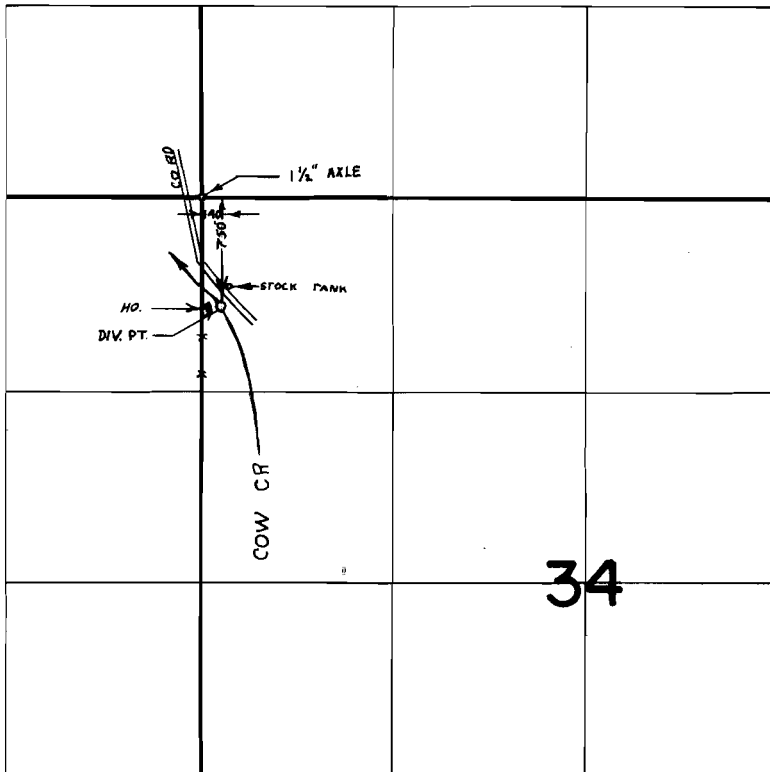

34

FINAL PROOF SURVEY UNDER

Application No. 43953 Permit No. 32838
IN NAME OF

DARWIN & ELIZABETH WILCOXEN

Surveyed JUNE 11, 1971, by R. MUCKEN