


T. 7 N. R. 9 W. W. M.

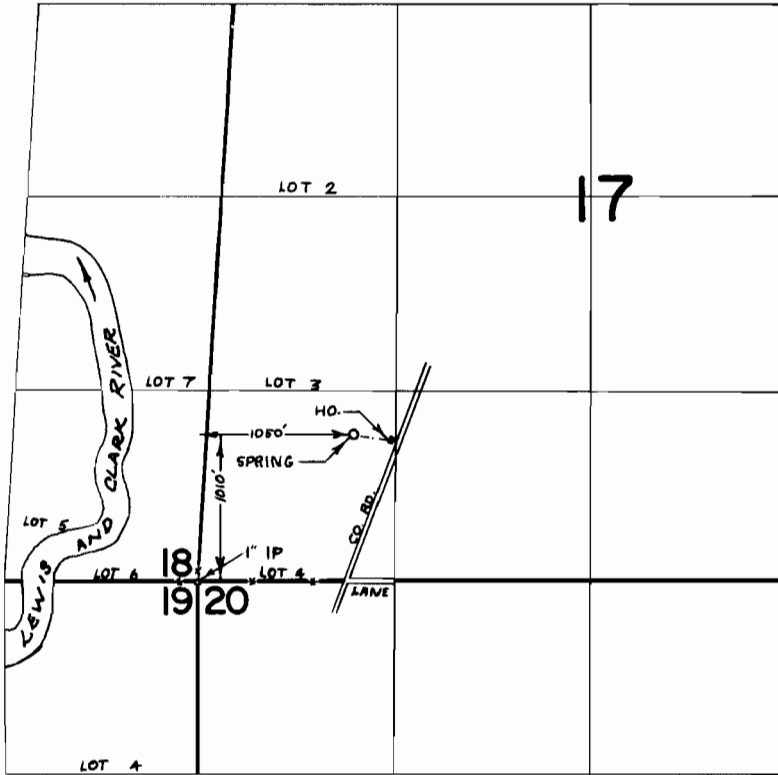

FINAL PROOF SURVEY
UNDER

Application No. 45268 Permit No. 33806
IN NAME OF

HARRY M. HUTCHINS

Surveyed JUNE 7, 1971, by R. MUCKEN