


T 26 S. R. 5 & 6 W. W.M.

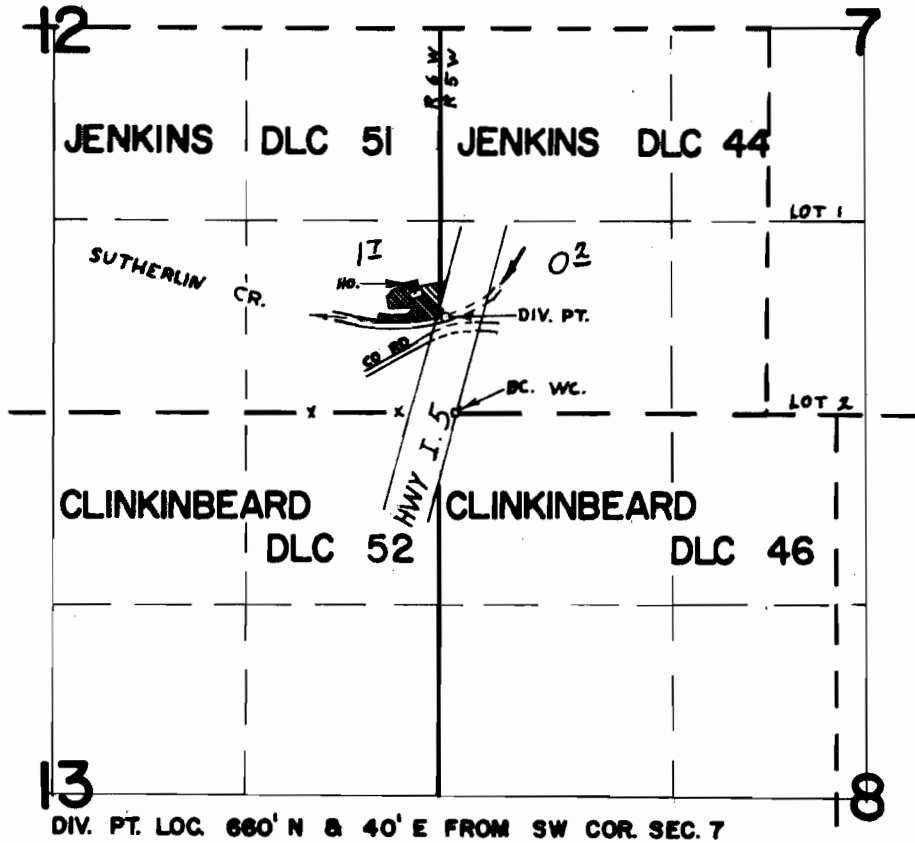

**FINAL PROOF SURVEY**  
UNDER

Application No. 43359 Permit No. 32406  
IN NAME OF

HARVEY D. & BEULAH B. CAREY

Surveyed APR. 15, 1971, by R. MUCKEN