


P-29092
38234

6

T 10 S. R. 27 E. W. M.

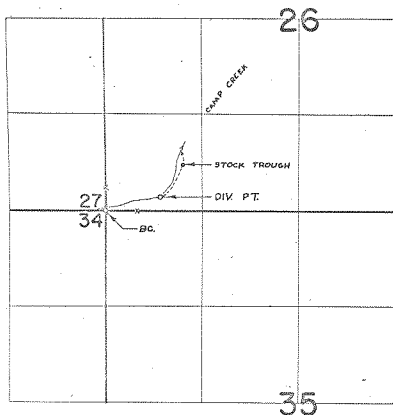

DIV. PT. LOC. 160' N & 740' E FROM SW COR. SEC. 26

FINAL PROOF SURVEY
UNDER

Application No. 39066... Permit No. 29092...
IN NAME OF

..... SOPHIE LEASY

Surveyed JULY 22, 1971., by R. MUCKEN.....