


# 33524<sup>4</sup>

# T. IS. R. IOE. W. M.

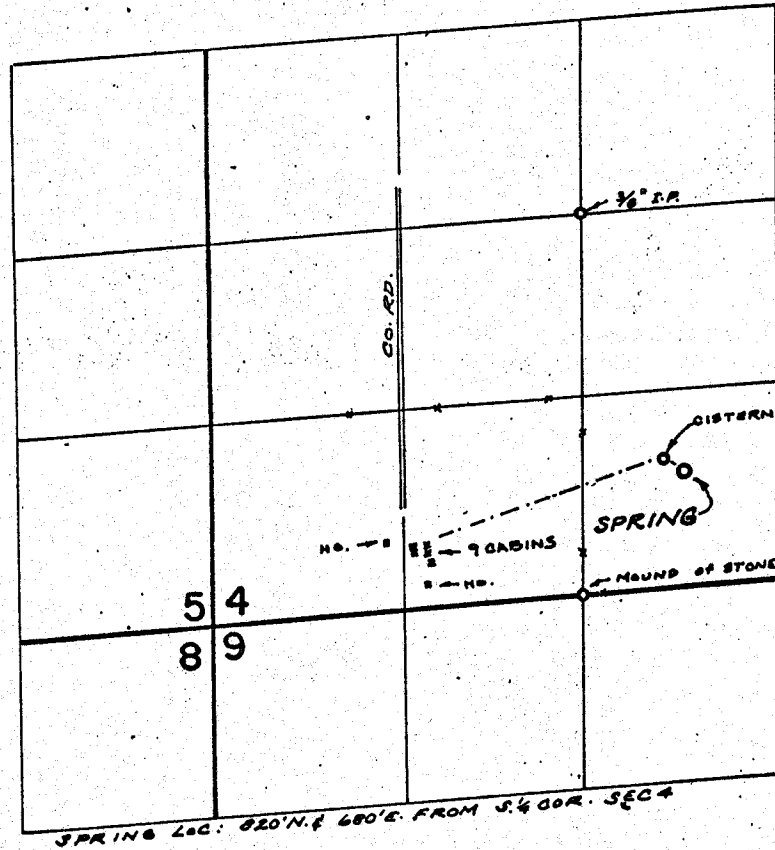

## FINAL PROOF SURVEY UNDER

Application No. 44821 Permit No. 33524  
IN NAME OF

KEITH W. & VICTORIA A. ADAMS

Surveyed MAY 25, 1971, by R. MUCKEN