


32767  
38237/19

# T. 39 S. R. 3 E. W. M

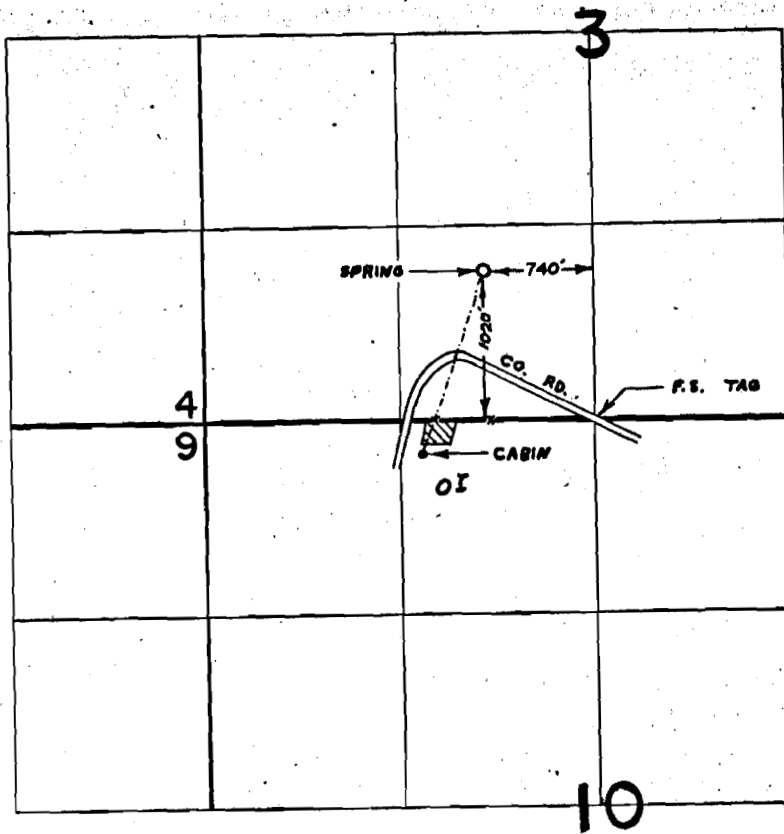

Keene Ck. misc.

## FINAL PROOF SURVEY UNDER

Application No. 43838... Permit No. 32767...  
IN NAME OF

.....DON G. SKILLMAN.....

Surveyed OCT. 19. 1971., by R. MUCKEN.....