


T. 3 5 S. R. 3 W. W. M.

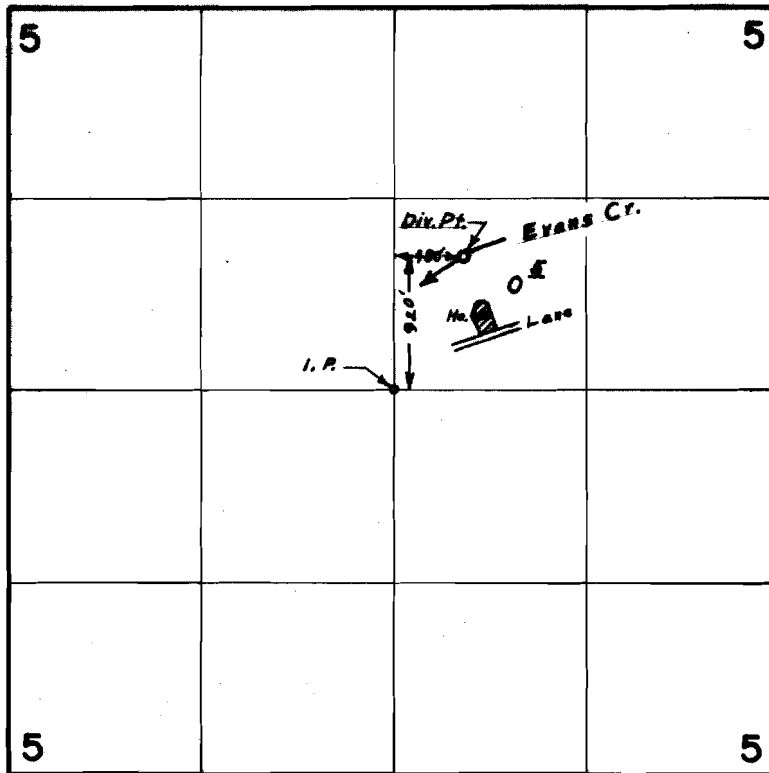

FINAL PROOF SURVEY
UNDER

Application No. 44048 Permit No. 32918
IN NAME OF

A. E. FRANCKE

Surveyed May 10 1971, by L. E. Gould