


T. 34 & 35 S. R. 3 W. W. M.

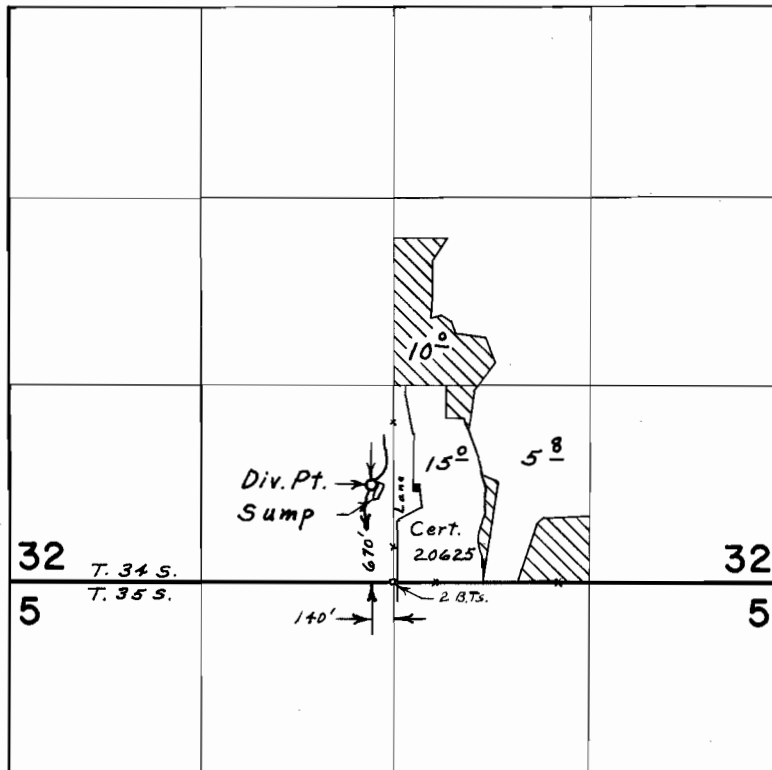

FINAL PROOF SURVEY
UNDER

Application No. 44504 Permit No. 33306
IN NAME OF

CHARLES D. GREENLAW

Surveyed May 8, 1971, by L. E. Gould