


T. 33S.R. 6W.W.M.

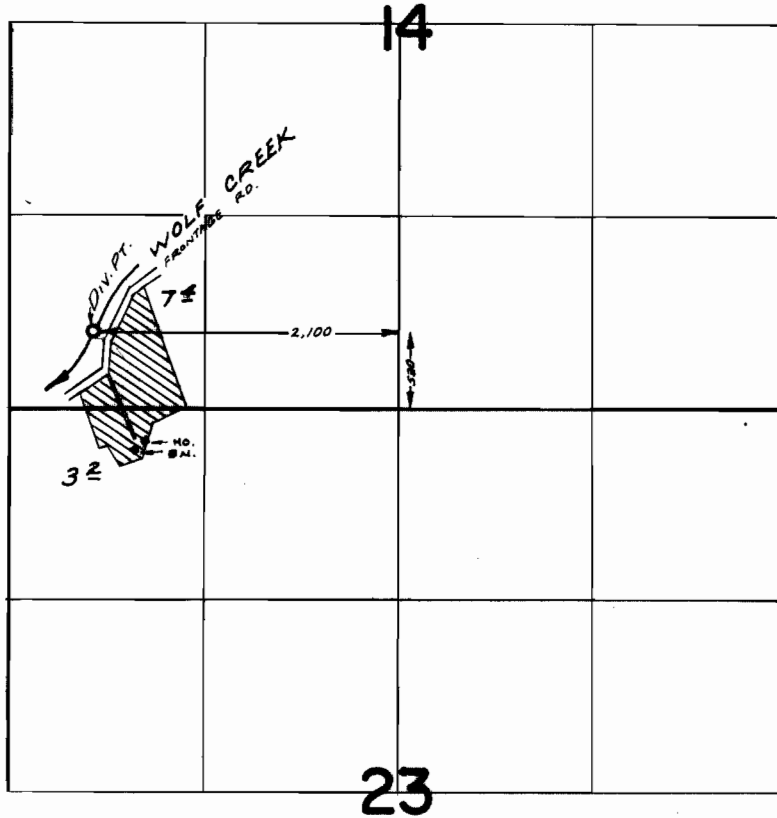

FINAL PROOF SURVEY
UNDER

Application No. 32662 Permit No. 29526
IN NAME OF

MRS. CLARENCE BENSCH

Surveyed APR. 17 1970, by R. MUCKEN