


T.34S.R.6W.W.M.

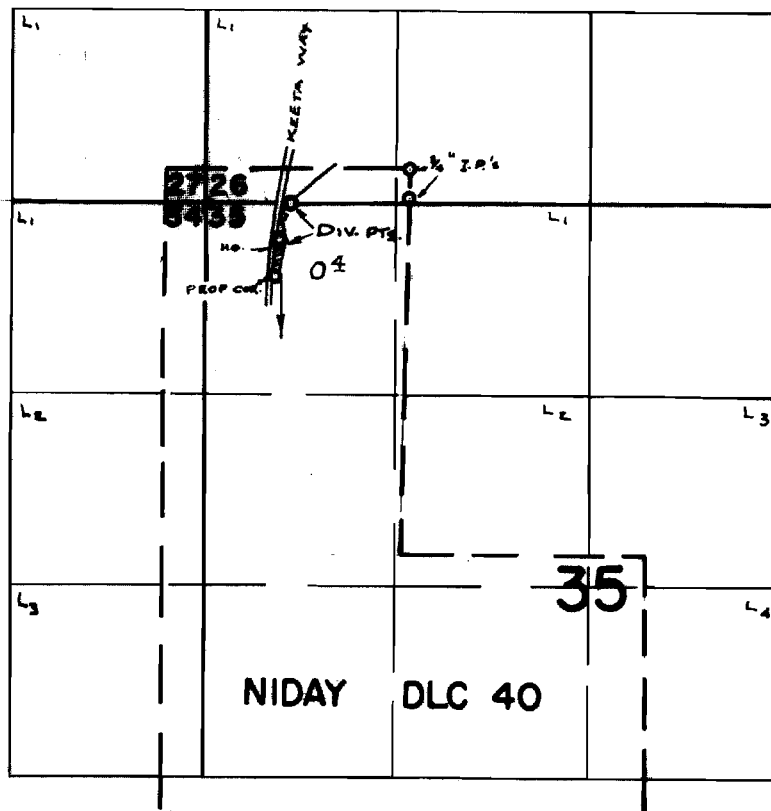

Div. Pts. Loc: 230' S. & 810' W. ; 480' S. & 890' W. Both
FROM NE. COR. DLC. 40

FINAL PROOF SURVEY
UNDER

Application No. 45496... Permit No. 34060...
IN NAME OF

RAYMOND W. & SYLVIA B. SPILLMAN

Surveyed APR. 28, 1970, by R. MUCKEN.