


G-32757

38244

# T. 36 S. R. 12 E. W.M.

Sprague River Wells

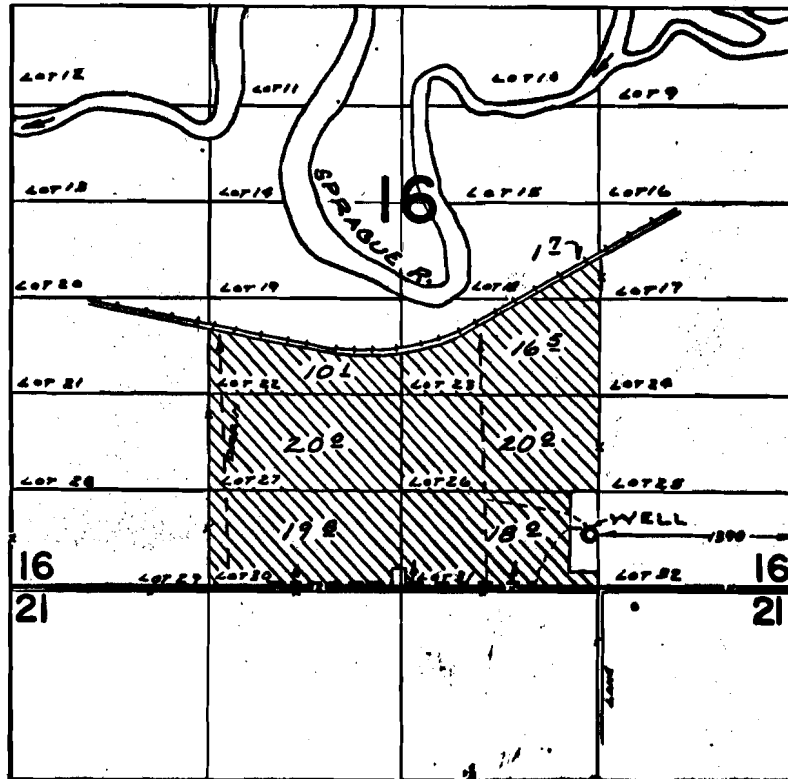

## FINAL PROOF SURVEY UNDER

Application No. G-2471 Permit No. G-3275  
IN NAME OF

BERNARD T. HEFFER

Surveyed MAY 16, 1970, by R. MUCKEN